


SCHEDULE "B"
SITE PLAN

Route 90



Safeway

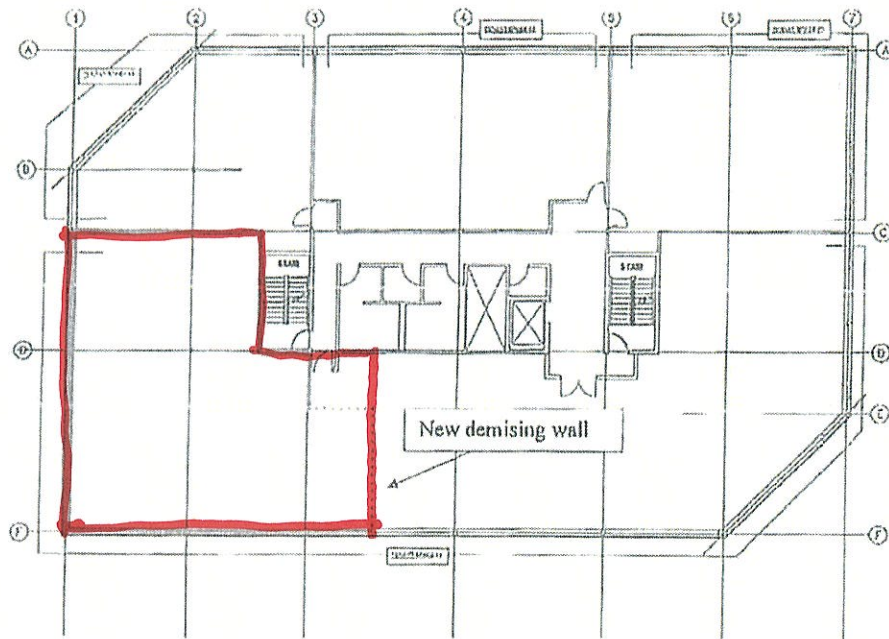