
OWINGS MILLS CORPORATE CAMPUS


10065 RED RUN BLVD. OWINGS MILLS, MD 21117
SUITE 120

TOTAL SF AVAILABLE -1,709 RSF (12%)

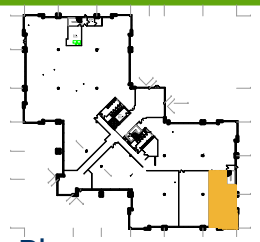

Key Plan

Click to access **CADD file**

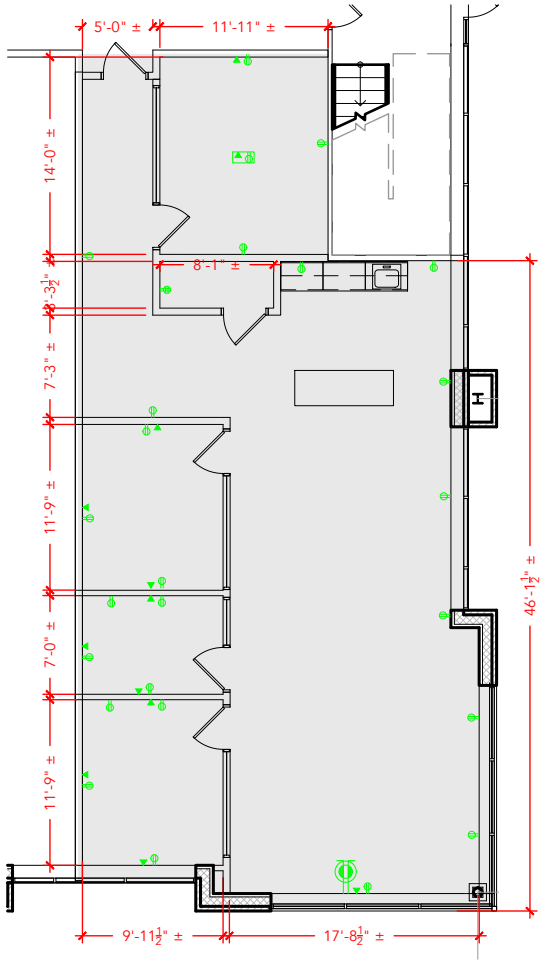

Floor Plan

PLAN NOT TO SCALE - THIS IS NOT A CONSTRUCTION DOCUMENT

DRAWING #: RR2-120 ASBUILT DATE: **NEEDS TO BE**