

PHASE 1

- 3 ROOMS ALONG the demizing WALL / common space
- EXPAND CEO OFFICE 2nd LEVEL

PHASE 2

- DEMO HR AREA
- CONSTRUCT NEW RETAIL STORE WITH NEW entrance from Vestibule

* = PERSONNEL WITH PRIVATE PRINTERS
F – HAS FURNITURE
E = NO FURNITURE
DBL = HAS 2 SETS OF FURNITURE

OFFICE/ WORKSTATION COUNTS:

OFFICES:	22
WORKSTATIONS:	84
RECEPTION/ ADMIN.:	1
TOTAL:	106
10 PERSON CONF. RM:	2
6 PERSON QUIET RM:	1
COLLABORATION AREAS:	2

LEGEND:
EXISTING CONSTRUCTION TO REMAIN
NEW CONSTRUCTION

CEO, LEGAL, FINANCE AND HR
CUSTOMER SERVICE
OPERATIONS AND PRODUCT DEV.
SALES, MARKETING, CREATIVE AND ENGINEERING
FACILITIES AND MIS
OPEN

CROSS SHEAFFER


299 Promenade St., Providence, RI

TEST LAYOUT- 2
1st FLOOR

Revised by C.Killian
June 16, 2016

CPG ARCHITECTS

SCALE: 1/8" = 1'-0"
JOB NO: 16034
APRIL 6, 2016 REV APRIL 19, 2016

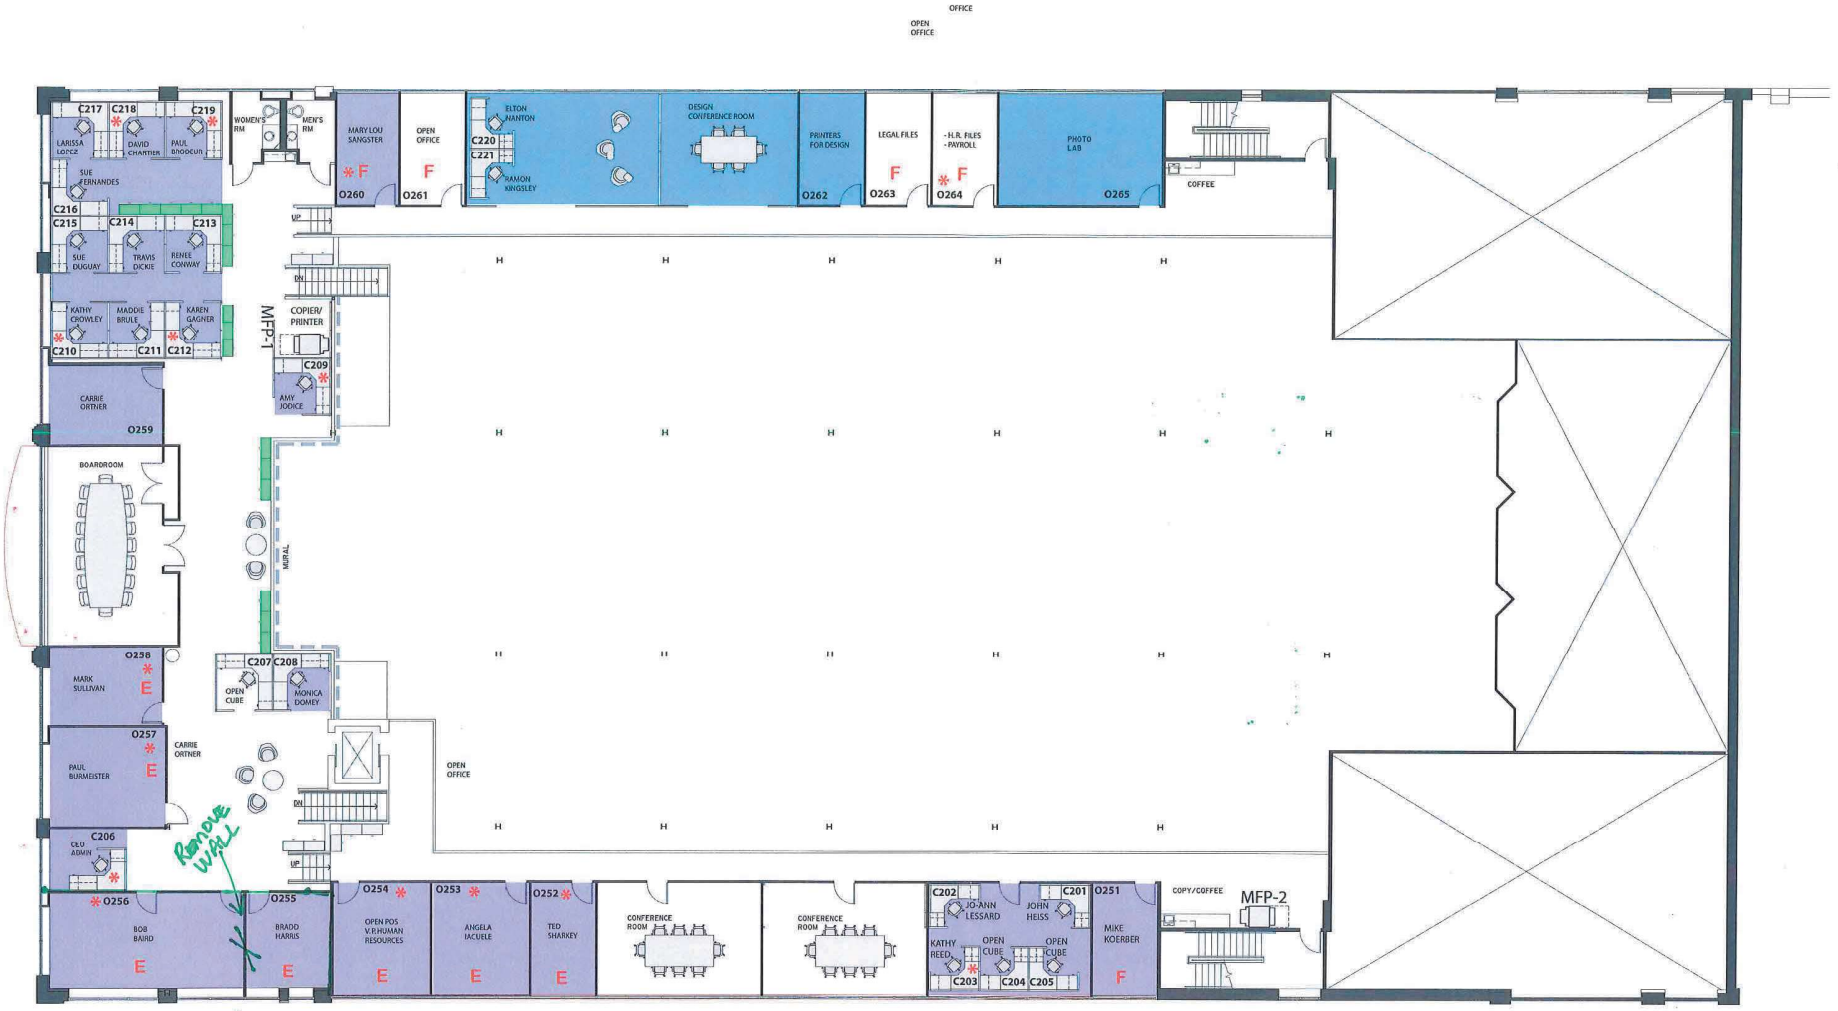

PHASE 1

* = PERSONNEL WITH PRIVATE PRINTERS
F = HAS FURNITURE
E = NO FURNITURE
DBL = HAS 2 SETS OF FURNITURE
= ACCOUNTING FILE CABINETS

OFFICE/ WORKSTATION COUNTS:

OFFICES:	16
WORKSTATIONS:	21
TOTAL:	37

16 BOARDROOM	1
8 PERSON CONF ROOM:	3

- CEO, LEGAL, FINANCE AND HR
- CUSTOMER SERVICE
- OPERATIONS AND PRODUCT DEV.
- SALES, MARKETING, CREATIVE AND ENGINEERING
- FACILITIES AND MIS
- HOT DESK/ INTERNS
- OPEN

CROSS SHEAFFER

299 Promenade St., Providence, RI

TEST LAYOUT- 1
2nd FLOOR

Revised by C.Killian
June 16, 2016

CPG ARCHITECTS

SCALE: 1/8" = 1'-0"
JOB NO: 160334
APRIL 5, 2016