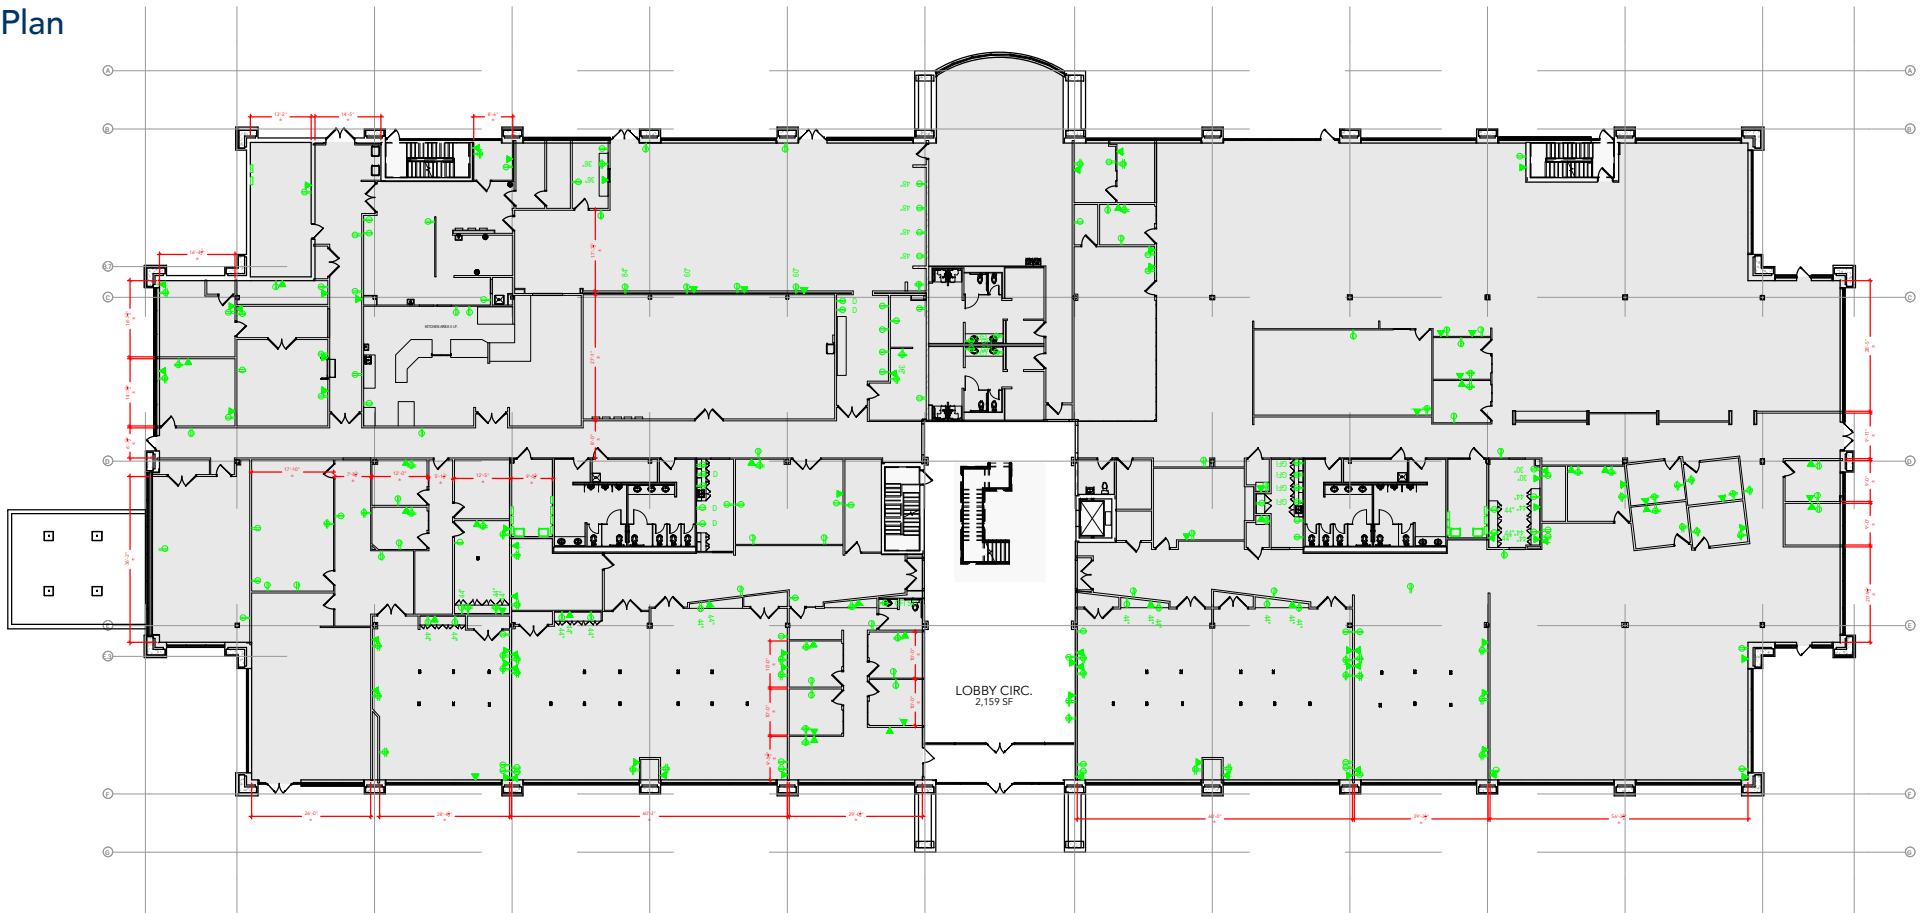


TOTAL SF AVAILABLE -50,411 RSF(9%)

[Click to access CADD file](#)**Key Plan****Floor Plan**