


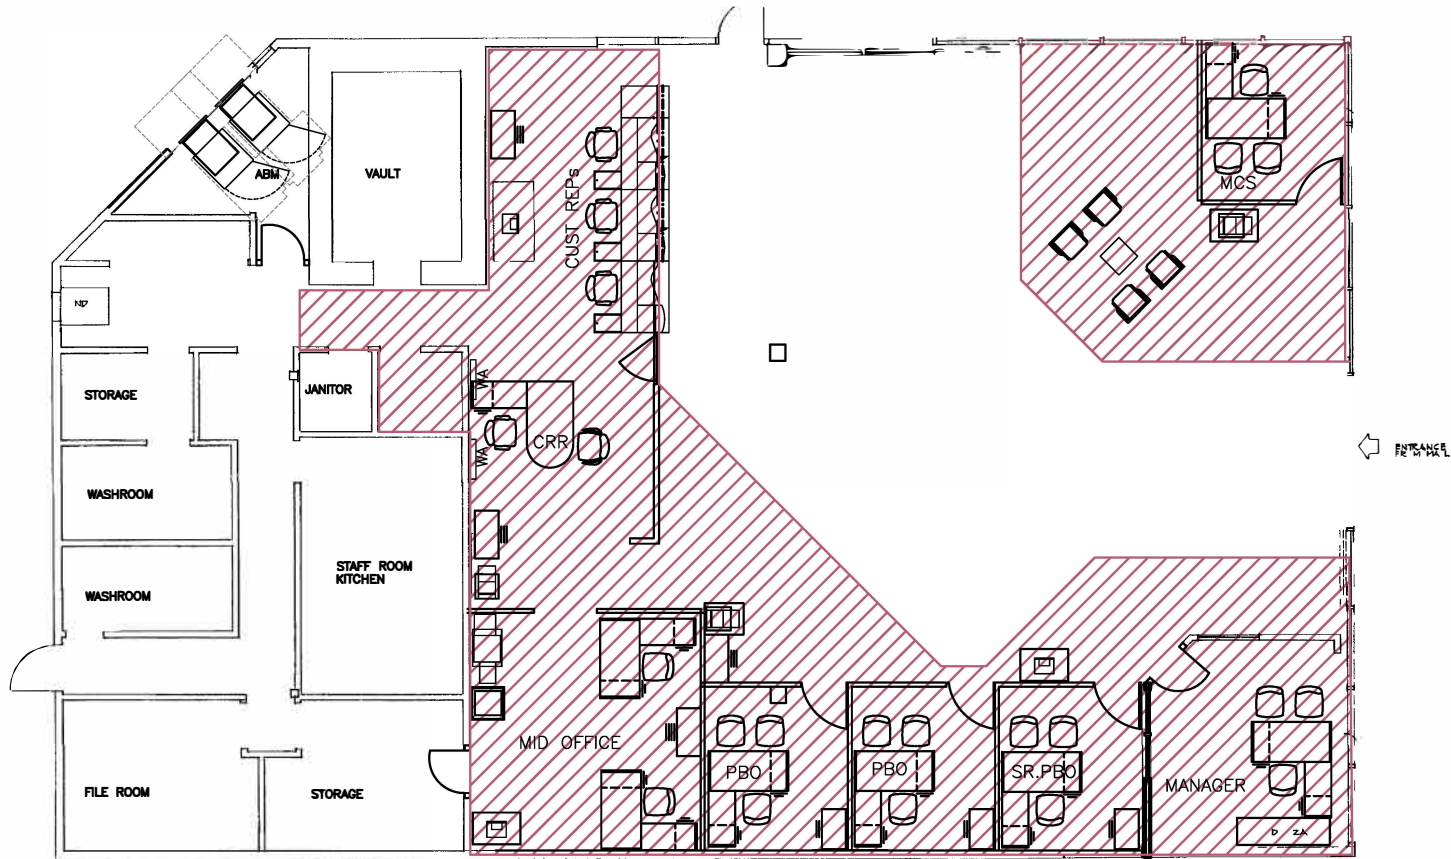

NOTE

THE ACTUAL FURNITURE ON SITE MAY VARY FROM THAT SHOWN ON THE DRAWING

2	NEW CARPET	RK	17 DEC 19
1	COLOUR SCHEME	NS	06 MAR 23

No.	REVISION	BY	DATE
-----	----------	----	------

THE CONSULTANT SHALL VERIFY ALL DIMENSIONS AND REPORT ANY INCONSISTENCIES BEFORE PROCEEDING
THIS DRAWING MUST NOT BE SCALED

CONSULTANT

NORTH



REAL ESTATE DEPARTMENT
SCOTIA PLAZA
44 KING STREET WEST
TORONTO, ONTARIO M5H 1H1
TEL: (416) 866-7871 FAX: (416) 866-4304

LOCATION

WETASKIWIN MALL
WETASKIWIN, ALBERTA

DRAWING

EXISTING FLOOR PLAN

DESIGNED BY	APPROVED BY
JG	
REGION	TRANSIT No.
AB	01479
DATE	SCALE
14 MAY 04	N.T.S.
BNS DWG No.	CONSULTANT'S DWG No.
01479DL1	.