


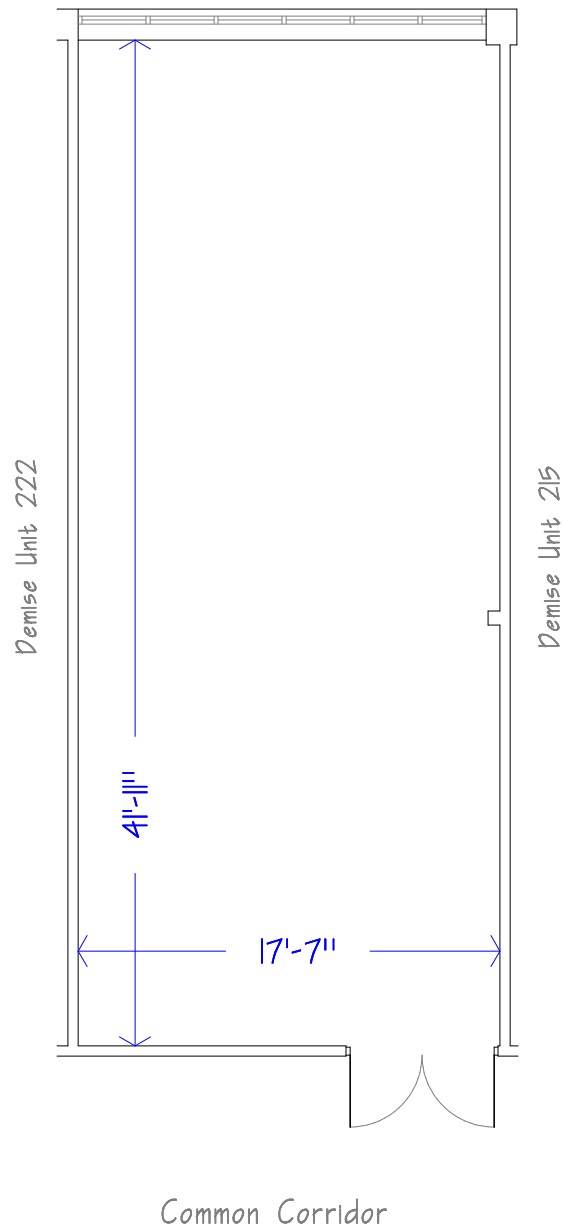

Unit 219
2770 Dufferin St
Toronto, Ontario

as measured March 13, 2024

