


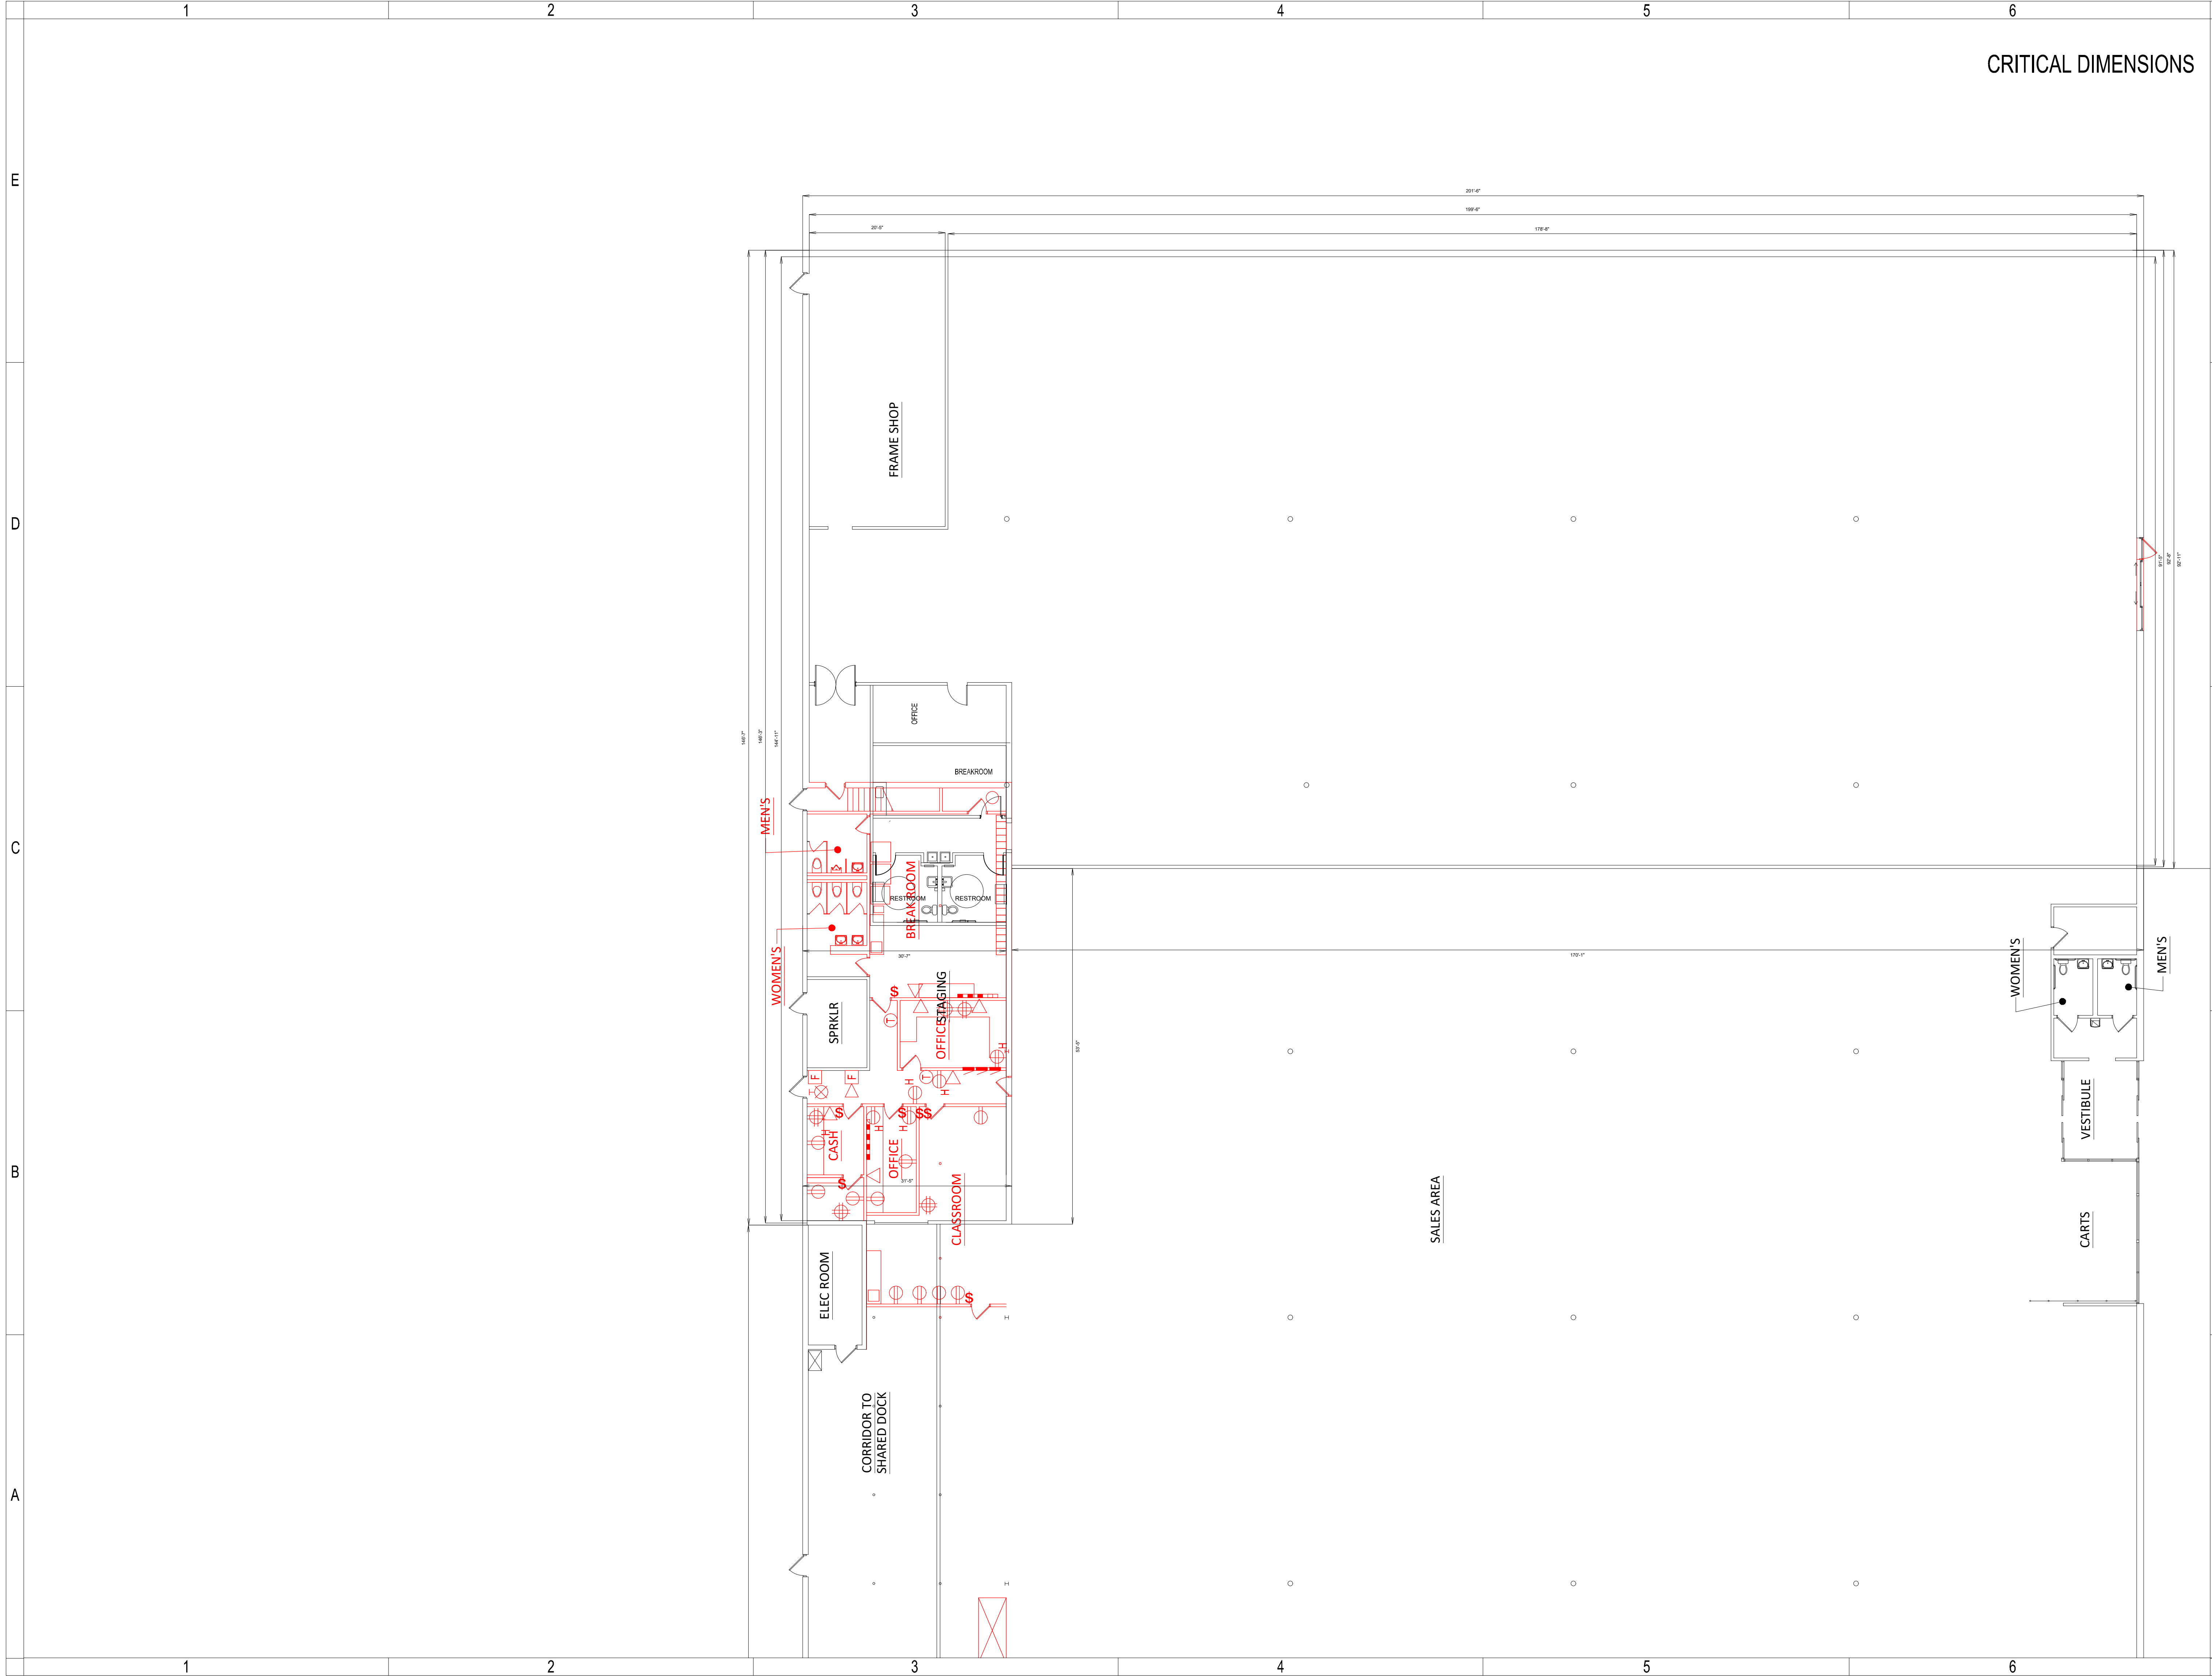

CRITICAL DIMENSIONS

SCALE: 3/32"=1'
LAYOUT #0 CONCEPT: L15
GONDOLA SYSTEM: -
SOFT OPENING DATE: 6/23/2019
PROJECT COMPLETION DATE:
START DATE: 07/30/2023
END DATE: 08/26/2023
PRINT DATE: 7/22/19
DRAWN BY: HEATHER LESLEY

PITT-MONROEVILLE #8315
MURRYSVIEW SHOPPES
5070 WILLIAM PENN HWY
MONROEVILLE, PA 15146
United States

DISTRICT: 207
ZONE: 2

DOWNSIZE

FLOOR FOOTAGE	
VESTIBULE.....	0 SF
CLASSROOM.....	0 SF
FRAMEROOM.....	828 SF
BREAKROOM.....	210 SF
OFFICES.....	171 SF
RESTROOMS.....	200 SF
OTHER.....	SF
HALLWAY.....	102 SF
JANITOR CLOSET.....	SF
STORAGE ROOM.....	SF
STAGING.....	1531 SF
TOTAL SUPPORT.....	3043 SF
ENCLOSED DOCK(A).....	SF

SALES CEILING.....
SUPPORT CEILING.....
STAGING CEILING.....

SALES AREA..... 16542 SF
SALES AREA %..... 81 %

MAIN FLOOR SQ FT(B) 20337 SF
MEZZANINE(C)..... SF
SECOND FLOOR(D)..... SF
UNUSED SPACE(E)..... SF
TOTAL AREA(SUM B:E)..... 20337 SF
TOTAL LEASABLE AREA..... 20337 SF
(MINUS DOCK & MEZZ) (SUM B:E-A-C)
TOTAL OPERATING SPACE 20337 SF
0

REVISIONS:

