


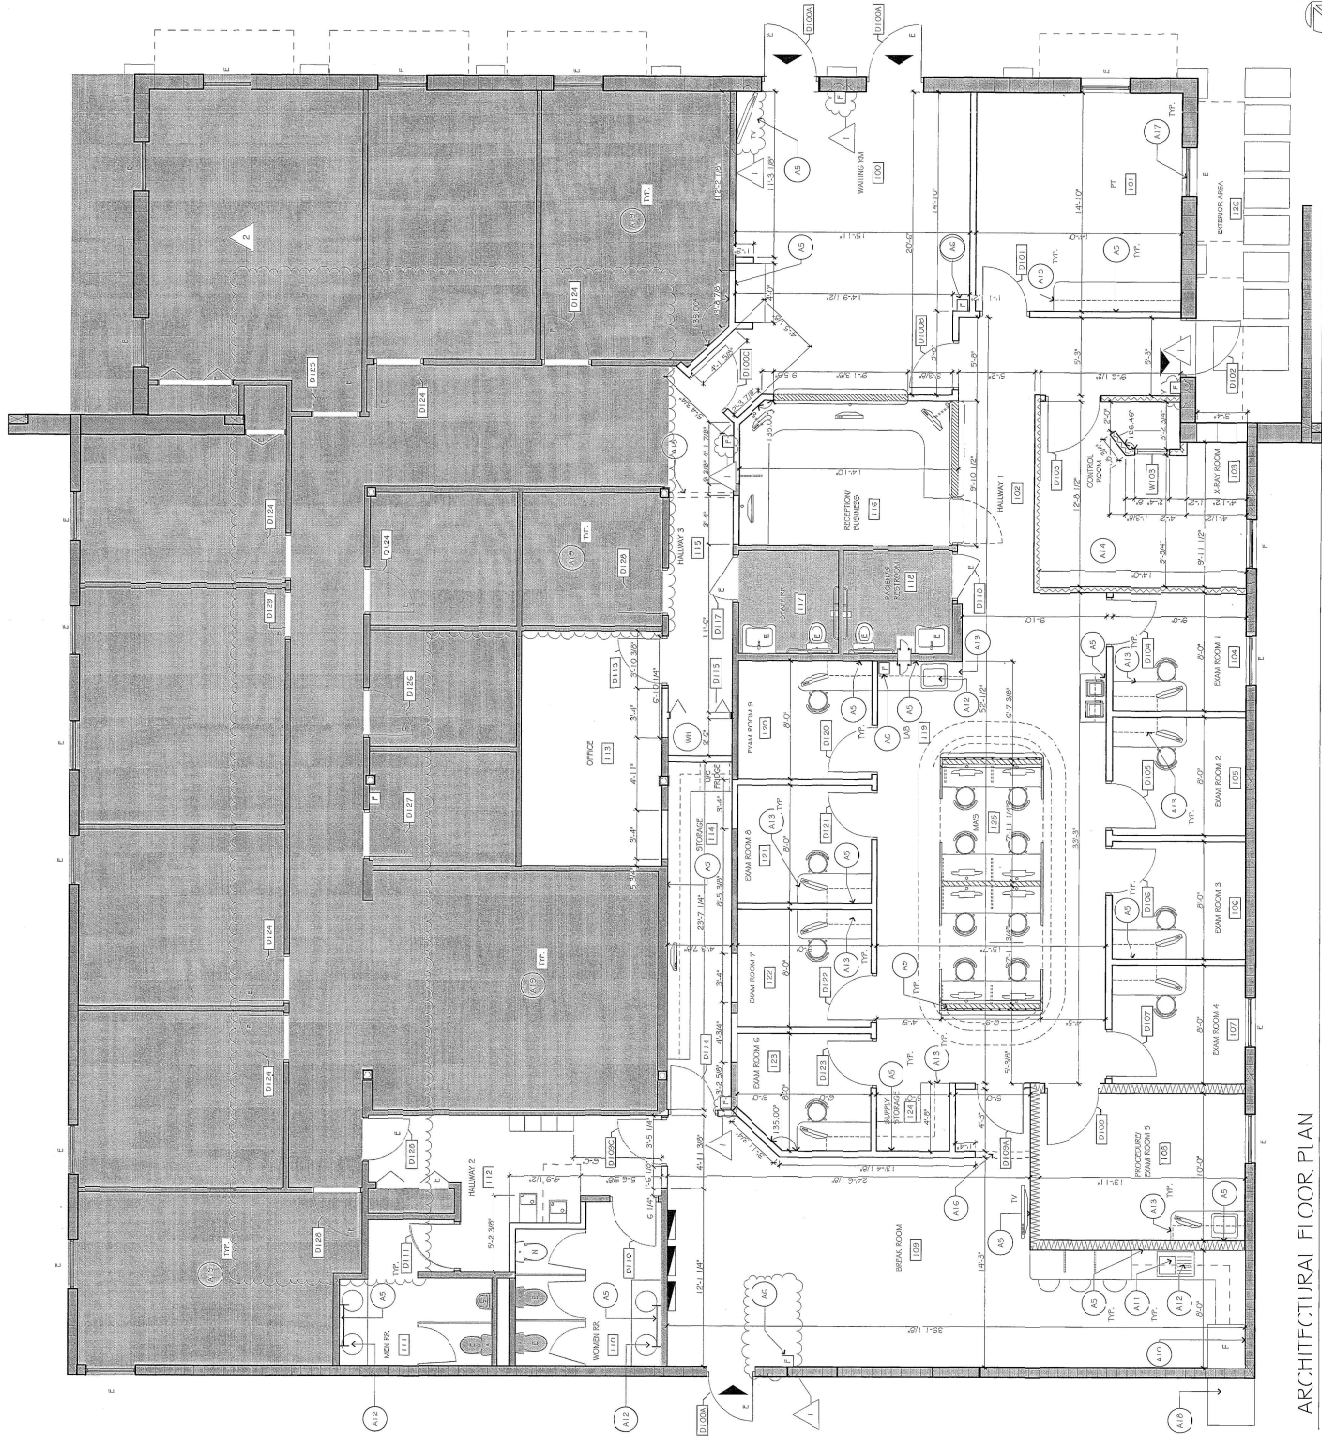

ARCHITECTURAL FLOOR PLAN



1/4" = 1'-0"

ARCHITECTURAL FLOOR PLAN & NOTES

Revised  
JUN 14, 2018  
Revised  
JUN 14, 2018

CITY OF FLORIAN  
BUILDING DEPT.  
APR 03 2018  
RECEIVED

- ARCHITECTURAL NOTES:**
- A1. REFER TO SPECIAL NOTES FOR FURTHER INFORMATION.
  - A2. CONTRACTOR TO OBTAIN ARCHITECT ATTENTION AND DISSEMINATE TO ALL TRADES ALL REVISIONS, PER THE IT'S COMMENCEMENT OF WORK.
  - A3. DIMENSIONS SHOWN ARE CLEAR FINISHED DIMENSIONS.
  - A4. PREPARE ALL FINISHES TO BE CLEAN, FINISHED DIMENSIONS.
  - A5. PROVIDE SOLID WOOD BACKING (PRED. BACKING) FOR CABINETS AND WALL MOUNTED FIXTURES, TYP.
  - A6. [ ] INDICATES 1/8" CRATED FIBER DENSITY BOARD MOUNTED PER FIBER DENSITY BOARD MANUFACTURER'S INSTRUCTIONS.
  - A7. TO ALL OTHERS, INDICATED IN DRAWING, THE INDICATED TO BE RELOCATED AND TO INDICATE TO BE RELOCATED.
  - A8. PROVIDE CRITICAL FINISHES AS NECESSARY TO ALL EXISTING WALLS THROUGHOUT PREMISES, TYP.
  - A9. PROVIDE A 1/2" HIGH PARTITION CONSTRUCTION, SEE DETAILS SHEET.
  - A10. PROVIDE WATER LINE TO REFRIGERATOR FOR ICE MAKER.
  - A11. PROVIDE NEW SINK AND FAUCET WITH COUNTER WATER.
  - A12. PROVIDE FINISHING CONNECTION TO NEW SINK.
  - A13. PROVIDE 1/4" THICK LAMINATE CABINETS, SHOWN "SWOP" DRAWINGS TO INDICATE THE APPEARANCE OF THE FINISHES IN THE TYP.
  - A14. REFER TO SHEET A-2 FOR FINISH DETAILS.
  - A15. PROVIDE NEW 2" EXTERIOR READER AS SHOWN.
  - A16. PROVIDE NEW 2" EXTERIOR READER AS SHOWN.
  - A17. PROVIDE NEW BUILDING SHADING WINDOW TREATMENTS @ ALL PERIMETER WINDOWS, TYP.
  - A18. PROVIDE ROOF ACCESS FLUSH LAUNDRY HATCH.
  - A19. NO WORK TO BE DONE, PROTECT ALL EXISTING CONDITIONS THAT REMAIN AS NECESSARY, TYP.

- WALL LEGEND:**
- EXISTING CMU WALL
  - EXISTING CONCRETE WALL
  - NEW CMU WALL
  - NEW INSULATED WALL
  - NEW SOUND WALL
  - NEW TYP. WALL
  - NEW TYP. WALL
  - LAND USED EXISTING FROM MANUFACTURER
  - REUSE

Spine & Orthopedic Center  
Medical Offices Extension - Plan Room  
4550 West Broward Blvd  
Plantation, Florida 33317

NOTED ON 3/26/18

DESIGN MATTERS  
MUMAW + ASSOCIATES, INC.  
ARCHITECTS  
