



Suite 140
2440
Texas Parkway
Level 01

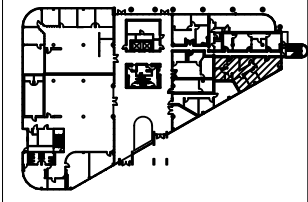

Suite Location:

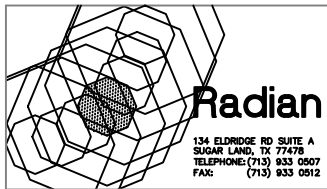

Suite Area:

1,430 NRSF

Project Number:


1994.CB

Scale:

1/8"=1'-0"

Sheet Number:

AB-140

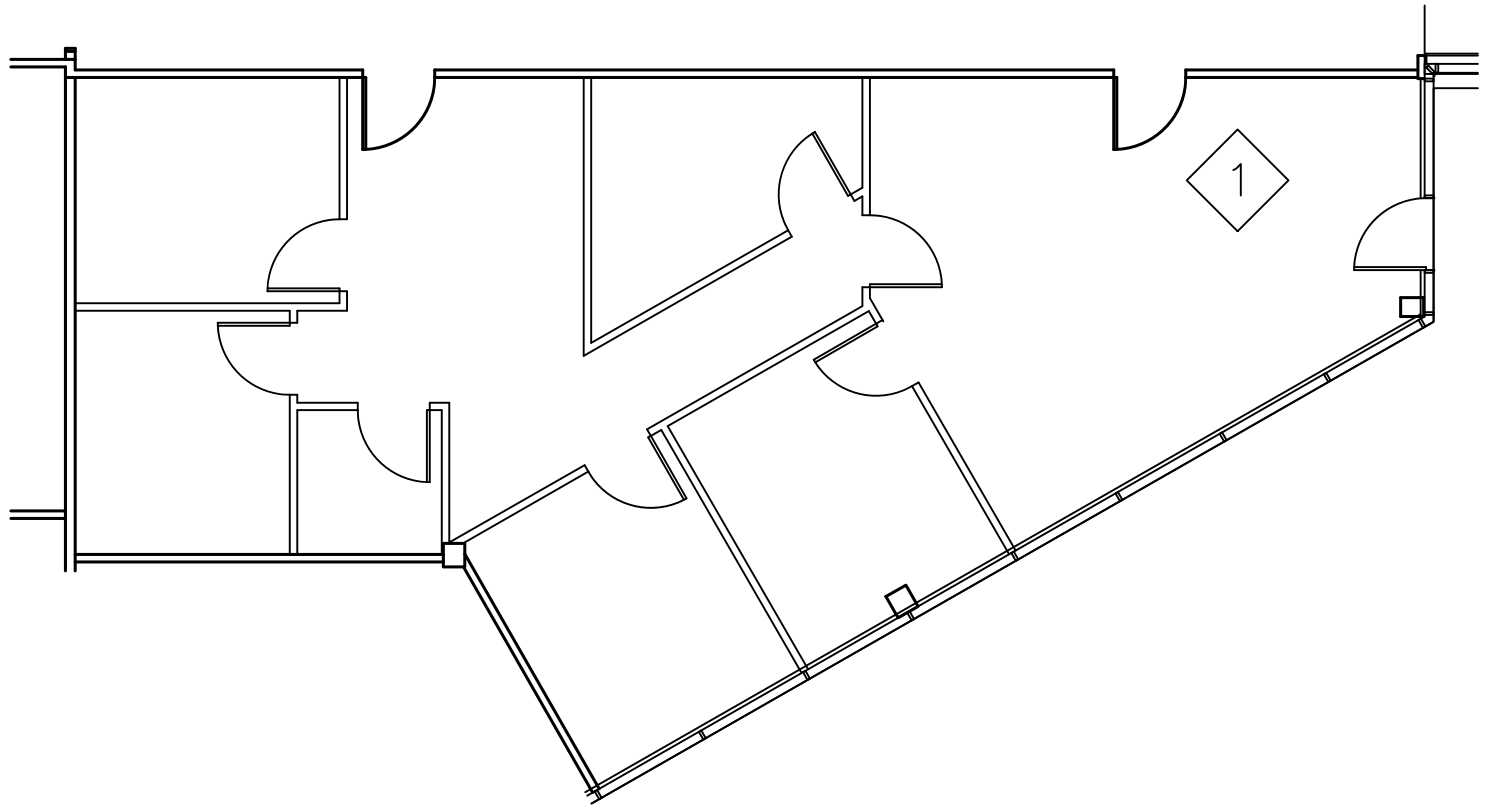

05.22.2019