

6 Merchant Street - Sharon - Off of Route 1 - Industrial/Office Flex

Sharon, MA

781.551.8888 x6



Industrial/Office Flex

\$14.95 NNN

±4,000 SF

Suites 2 consisting of ± 4,000 SF
This beautifully built out Industrial
Office/Flex Space with one (1)
loading dock, storage, large open
work spaces, and multiple offices.

This location is directly off of Route 1
with easy access to Route 95 close
proximity to Walpole, Sharon,
Foxboro.

For more information or to schedule a tour, please contact:

Bryan Glennon

781 551 8888 x6

bg@atlanticre.com

Mark Kearins

781 551 8888 x1

mk@atlanticre.com



Atlantic Commercial
Real Estate, LLC

Atlantic Commercial Real Estate, LLC

123 Washington Street, Suite 7

Foxboro, MA 02035

Office: 781.551.8888

Direct: 774-581-0086


atlanticre.com

On all sales, the exclusive broker is an agent of the seller and not the buyer. In addition, no warranty or representation, express or implied, is made as to the accuracy of the information contained herein, and same is submitted subject to errors, omissions, change of price, rental or other conditions, withdrawal without notice, and to any special listing conditions, imposed by our principals. Copyright © 2013 Atlantic Commercial Real Estate, LLC

6 Merchant Street

Sharon, MA

781.551.8888 x6

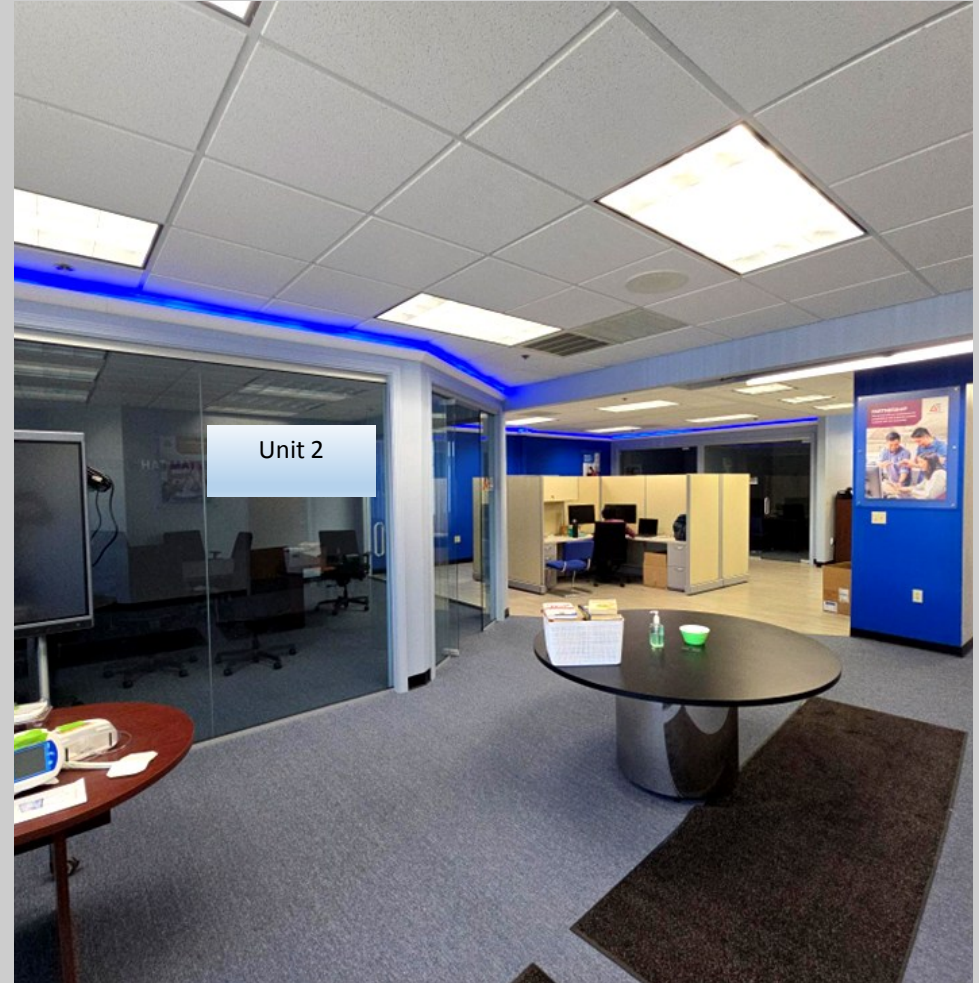

Atlantic Commercial
Real Estate, LLC

Atlantic Commercial Real Estate, LLC
123 Washington Street, Suite 7
Foxboro, MA 02035


Office: 781.551.8888
Direct: 774-581-0086
atlanticre.com

Copyright © 2013 Atlantic Commercial Real Estate, LLC

6 Merchant Street

Sharon, MA

781.551.8888 x6

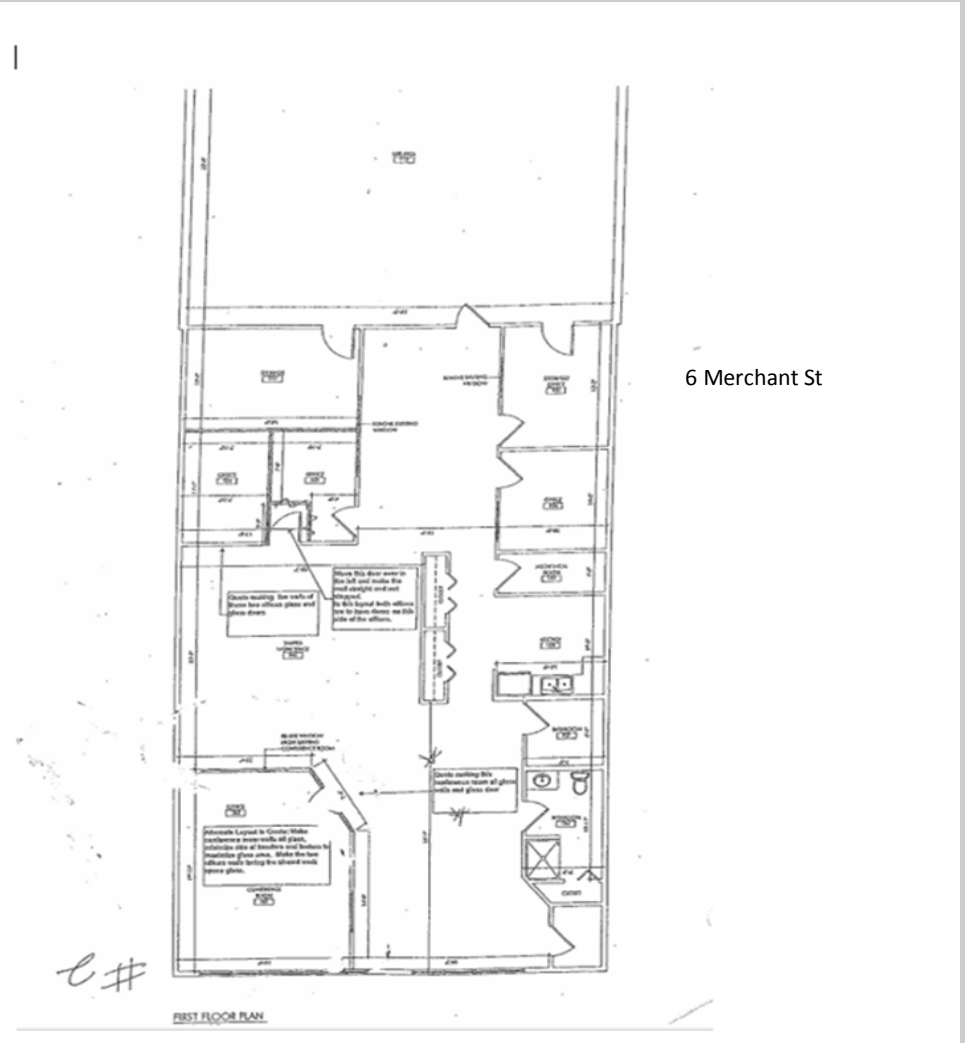

6 Merchant St



Atlantic Commercial
Real Estate, LLC

Atlantic Commercial Real Estate, LLC

123 Washington Street, Suite 7

Foxboro, MA 02035

Office: 781.551.8888

Direct: 774-581-0086

atlanticre.com

Copyright © 2013 Atlantic Commercial Real Estate, LLC