

SURVEYOR LOCATION REPORT

This report was prepared only for:

JOHN LONG, OWNER

THIS REPORT IS DESIGNED FOR USE BY A TITLE INSURANCE COMPANY WITH RESIDENTIAL LOAN POLICIES. NO CORNER MARKERS WERE SET AND THE LOCATION DATA HEREIN IS BASED ON LIMITED ACCURACY MEASUREMENTS. THEREFORE, NO LIABILITY WILL BE ASSUMED FOR ANY USE OF THIS DATA FOR CONSTRUCTION OF NEW IMPROVEMENTS OR FENCES. THIS REPORT IS NOT INTENDED TO REPRESENT A SURVEY, NOR IS IT INTENDED TO BE USED BY AND/OR BENEFIT THE BORROWER(S).



PROPERTY ADDRESS: 345 E. Park Street


PROPERTY DESCRIPTION: Lot 4 in WATSON'S SUB-DIVISION to the Town of Westfield, Indiana, the plat of which is recorded in Plat Book 2, pages 80-81, in the Office of the Recorder of Hamilton County, Indiana.

This is to certify that the subject property does not lie within that Special Flood Hazard Area Zone "A". The accuracy is subject to map scale uncertainty and to any other uncertainty in location or elevation on Community Panel Number 18057C0136G of the Flood Insurance Rate Maps, effective date 11/19/2014.

BORROWER(S): John Long

SURVEYOR LOCATION REPORT


I hereby certify to the parties named above that the real estate described herein was inspected under my supervision on the date indicated and that to the best of my knowledge, this report conforms with the requirements contained in Sections 27 through 29 of 865 IAC 1-12 for a SURVEYOR LOCATION REPORT.

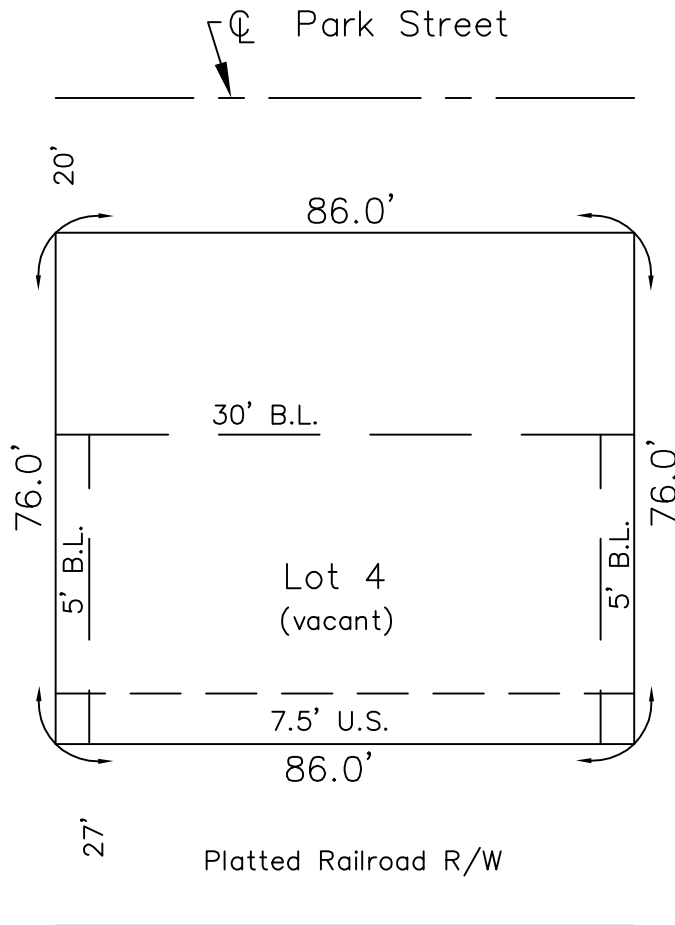

Scale: 1" = 30'

P&H
ENGINEERING/SURVEYING LLC

5251 S. East Street #1
INDIANAPOLIS, IN 46227
PHONE: (317) 974-5555
FAX: (317) 974-5570

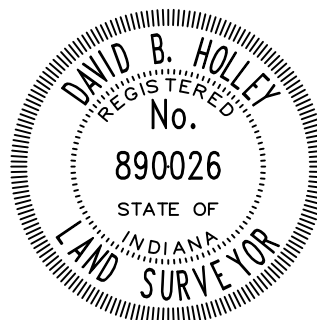

CERTIFIED: 01/07/2020

David B. Holley
David B. Holley
Professional Surveyor,

Indiana #890026
Job No.: 20011006
Sheet 2 of 2