



Suite 160
2440
Texas Parkway
Level 01

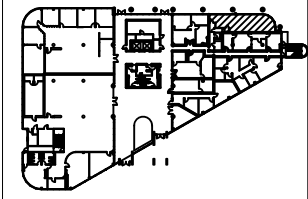

Suite Location:

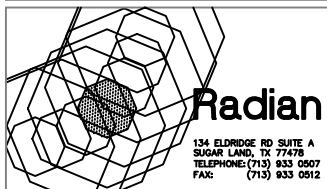

Suite Area:

923 NRSF

Project Number:


2194.CB

Scale:

1/8"=1'-0"

Sheet Number:

AB-160

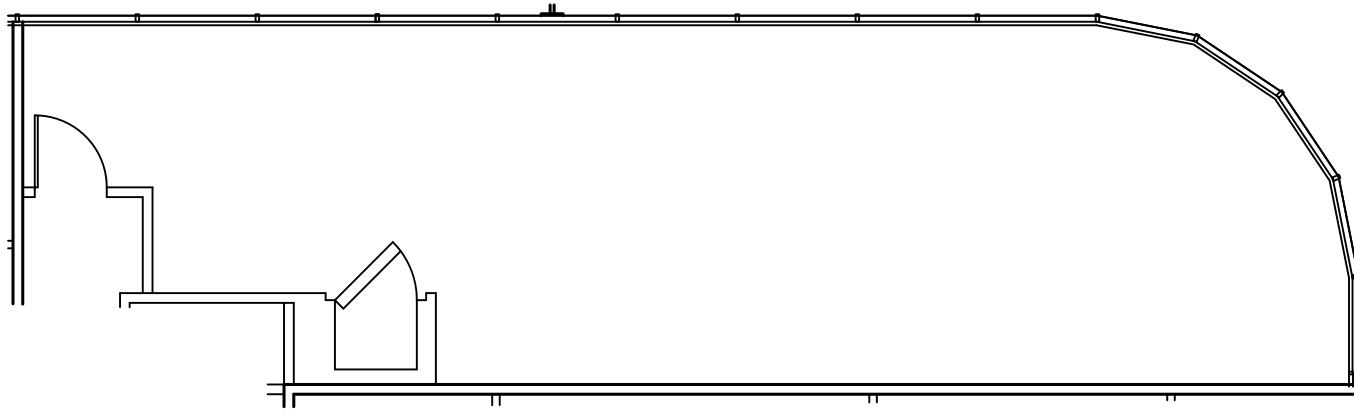

12.21.2021