


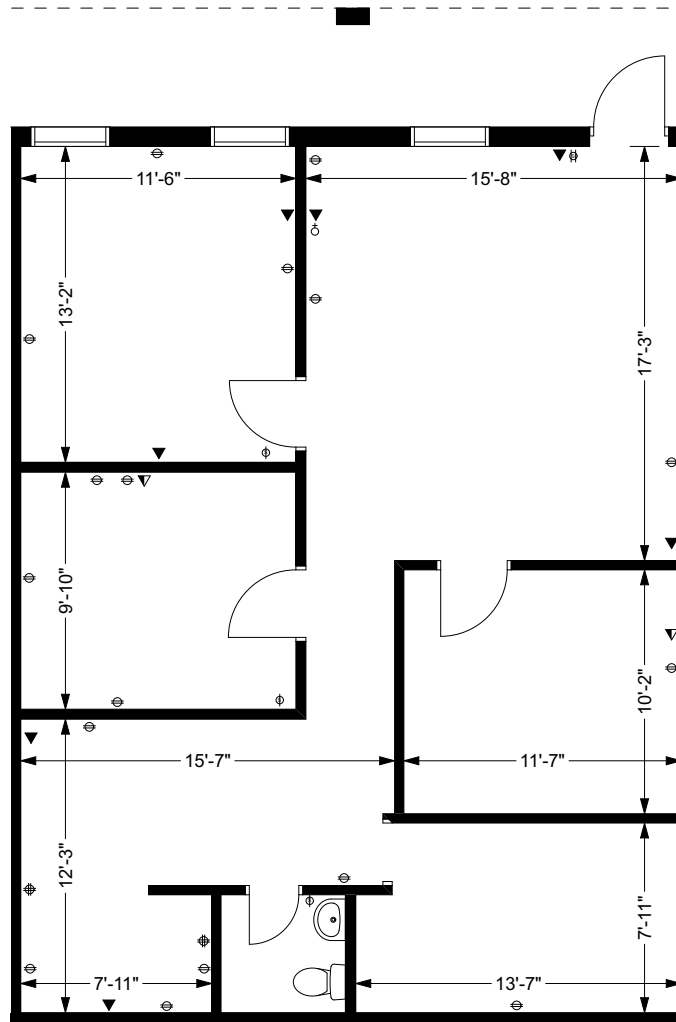

| Wall Plan Legend |                   |  |                         |
|------------------|-------------------|--|-------------------------|
|                  | THERMOSTAT        |  | CABLE RECEPTACLE        |
|                  | DOUBLE RECEPTACLE |  | ELECTRICAL PANEL        |
|                  | QUAD RECEPTACLE   |  | VOICE RECEPTACLE        |
|                  | SINGLE SWITCH     |  | DATA RECEPTACLE         |
|                  | DOUBLE SWITCH     |  | VOICE & DATA RECEPTACLE |



**95 Office Park**  
**2750 N 29th Avenue**  
**Hollywood, FL 33020**

**Suite 202**  
**1,042 RENTABLE SF**

Measured: 03/22/21  
 Prepared: 05/08/21

Plan Version: V1

**Leasing & Management:**

**FIRM Realty**  
 1930 Harrison Street  
 Suite 503  
 Hollywood, FL 33020  
 (954) 926-2510



phone: (305) 702-0590  
[www.floridameasures.com](http://www.floridameasures.com)  
[mail@floridameasures.com](mailto:mail@floridameasures.com)  
[@floridameasures](https://twitter.com/floridameasures)



This work product has been prepared by Florida Measures, LLC pursuant to a contract with the Client for the sole benefit of and use by the Client. No third party may rely on this work product without the receipt of a reliance letter from Florida Measures, LLC.