



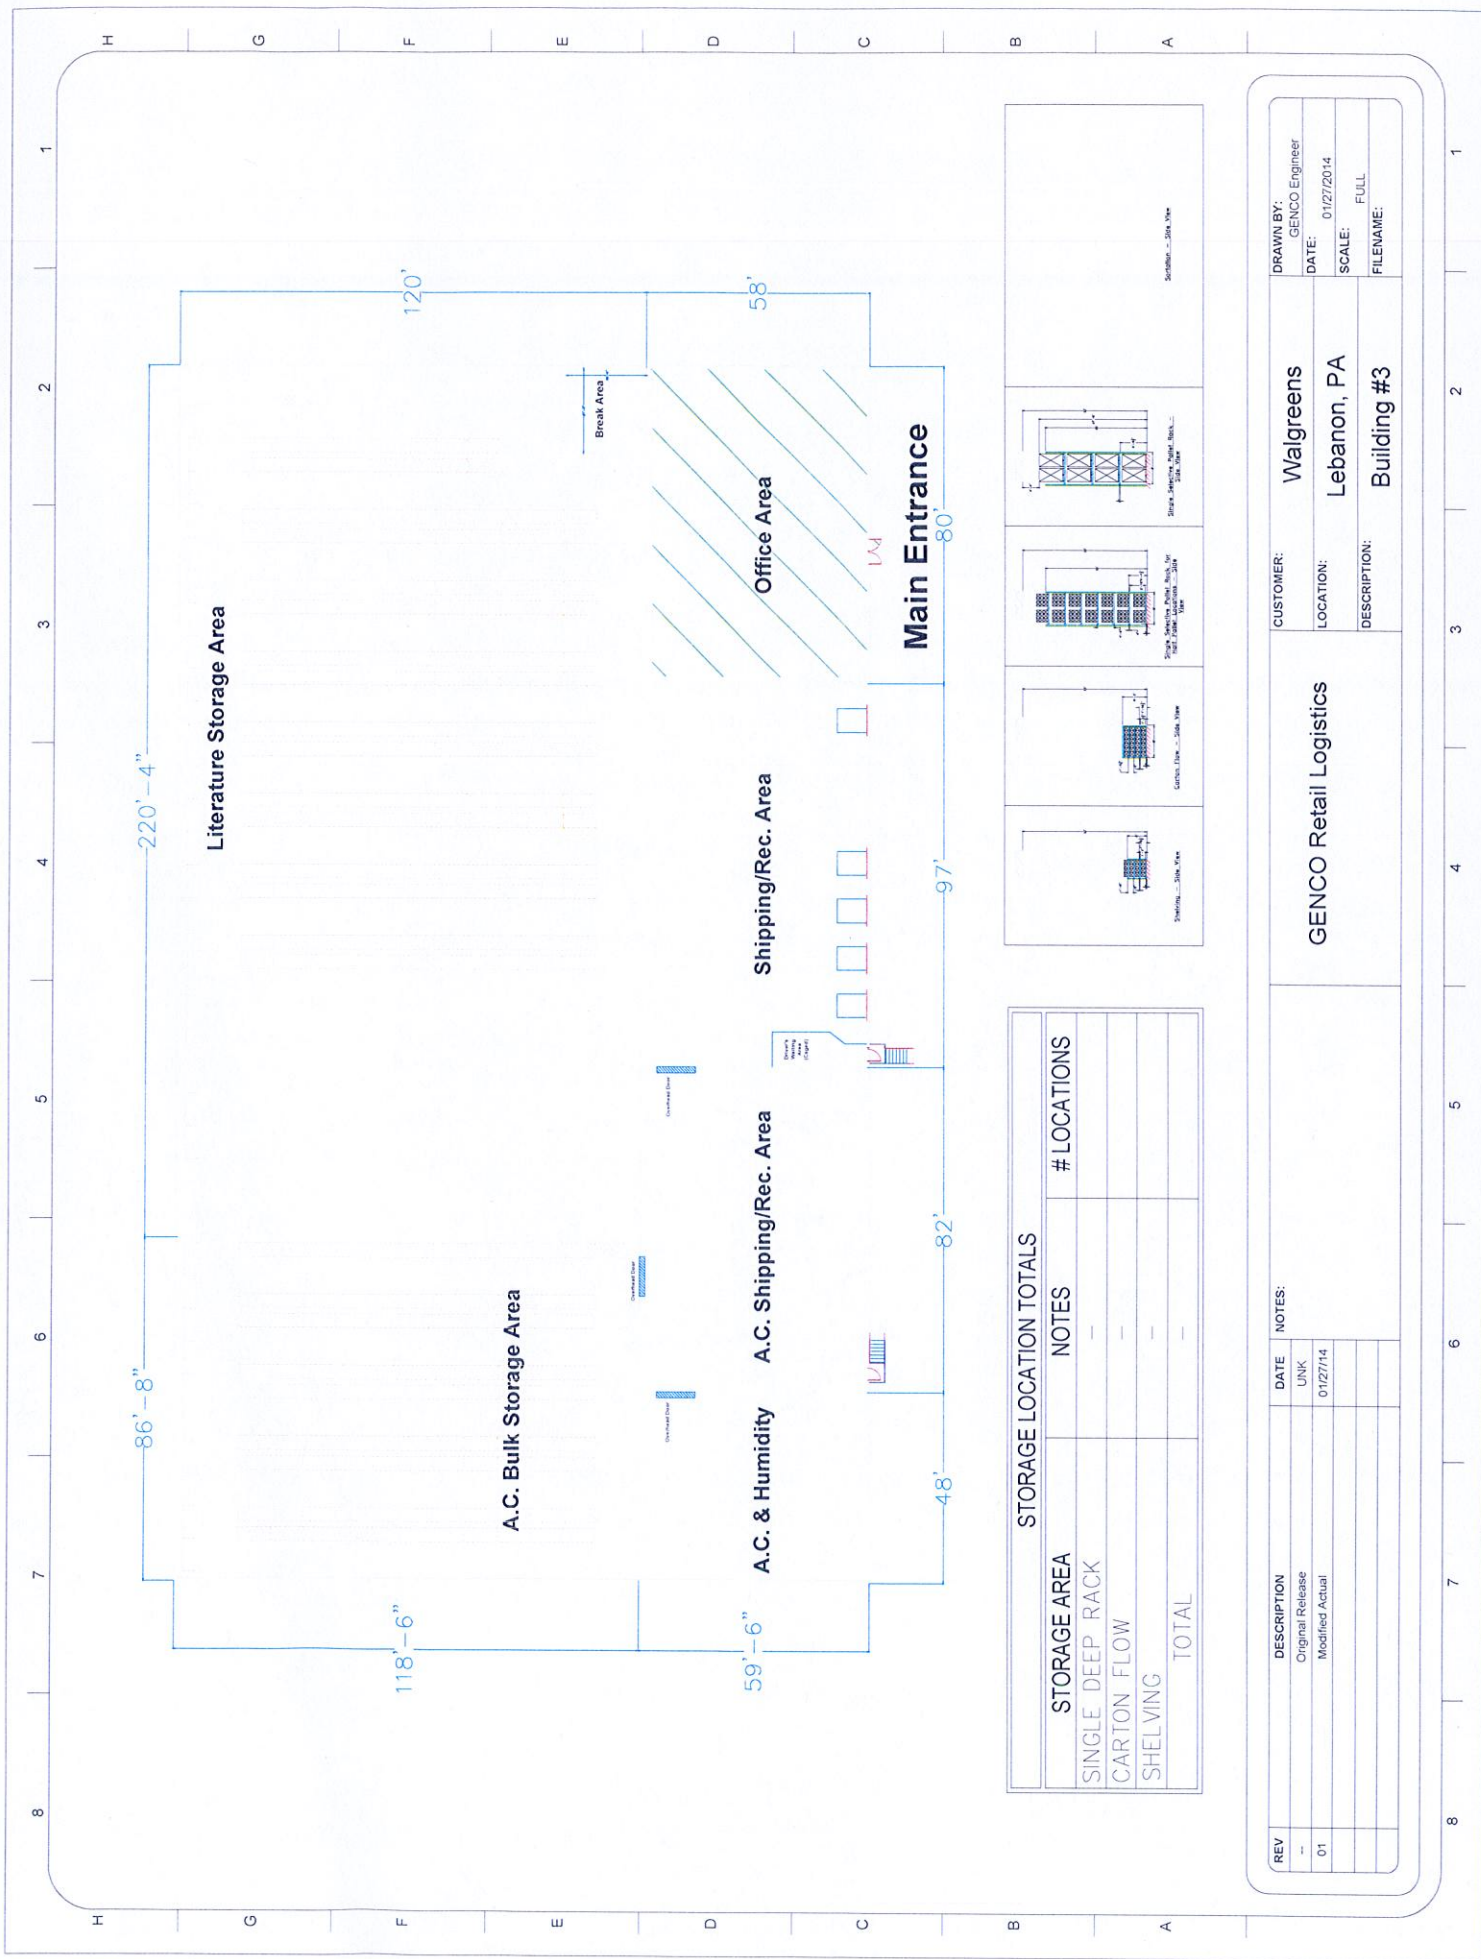

STORAGE LOCATION TOTALS		
STORAGE AREA	NOTES	# LOCATIONS
SINGLE DEEP RACK	—	
CARTON FLOW	—	
SHELVING	—	
TOTAL	—	

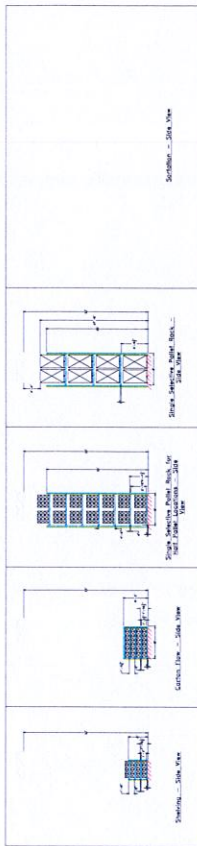

REV	DESCRIPTION	DATE	NOTES
—	Original Release	UNK	
01	Modified Actual	01/27/14	

GENCO Retail Logistics			
CUSTOMER:	Walgreens	LOCATION:	Lebanon, PA
DESCRIPTION:	Building #3		

DRAWN BY:	GENCO Engineer
DATE:	01/27/2014
SCALE:	FULL
FILENAME:	