

2614 West Jefferson Street
Joliet, IL 60435



Entrance




Interior


Parking Lot

**West Jefferson Street
Parking Lot**

MAIN FLOOR

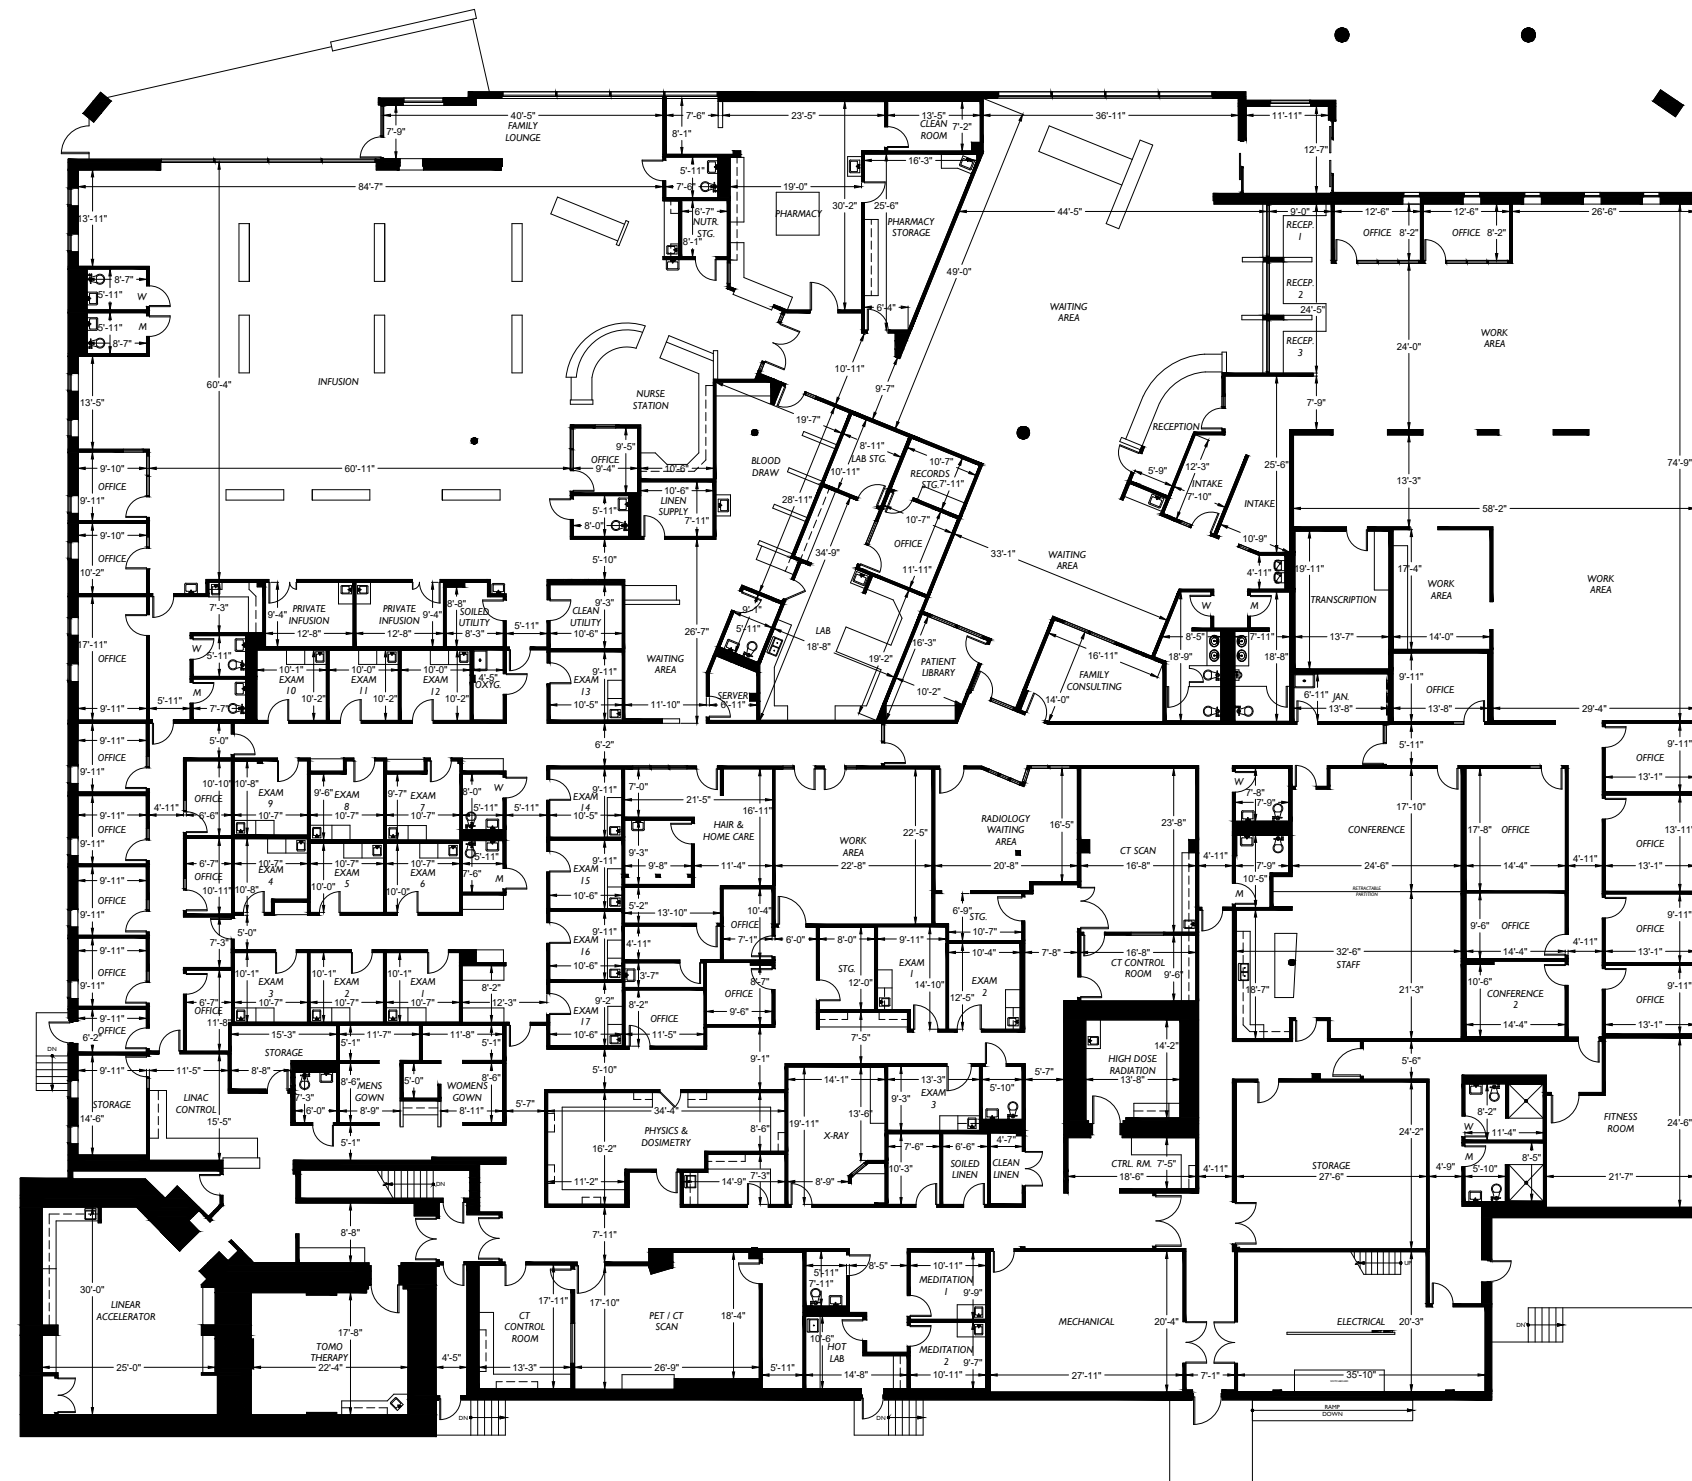

Service Drive

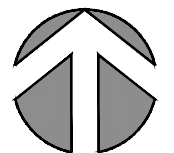

**Adjacent Retail Building
Parking Lot
Caterpillar Drive**

Community Healthcare Trust 3326 Aspen Grove Drive Suite 150 Franklin, TN 37067	Presence Cancer Care 2614 West Jefferson Street Joliet, IL 60435	Floor Plan 	2-D AS-BUILT FLOOR PLANS 2DFLOORPLANS.COM 206-328-7410 600 NW Gilman Blvd. Suite E Issaquah, WA 98027
Client	Subject	Floor	Measured: December 2017 Project: C17-1056