


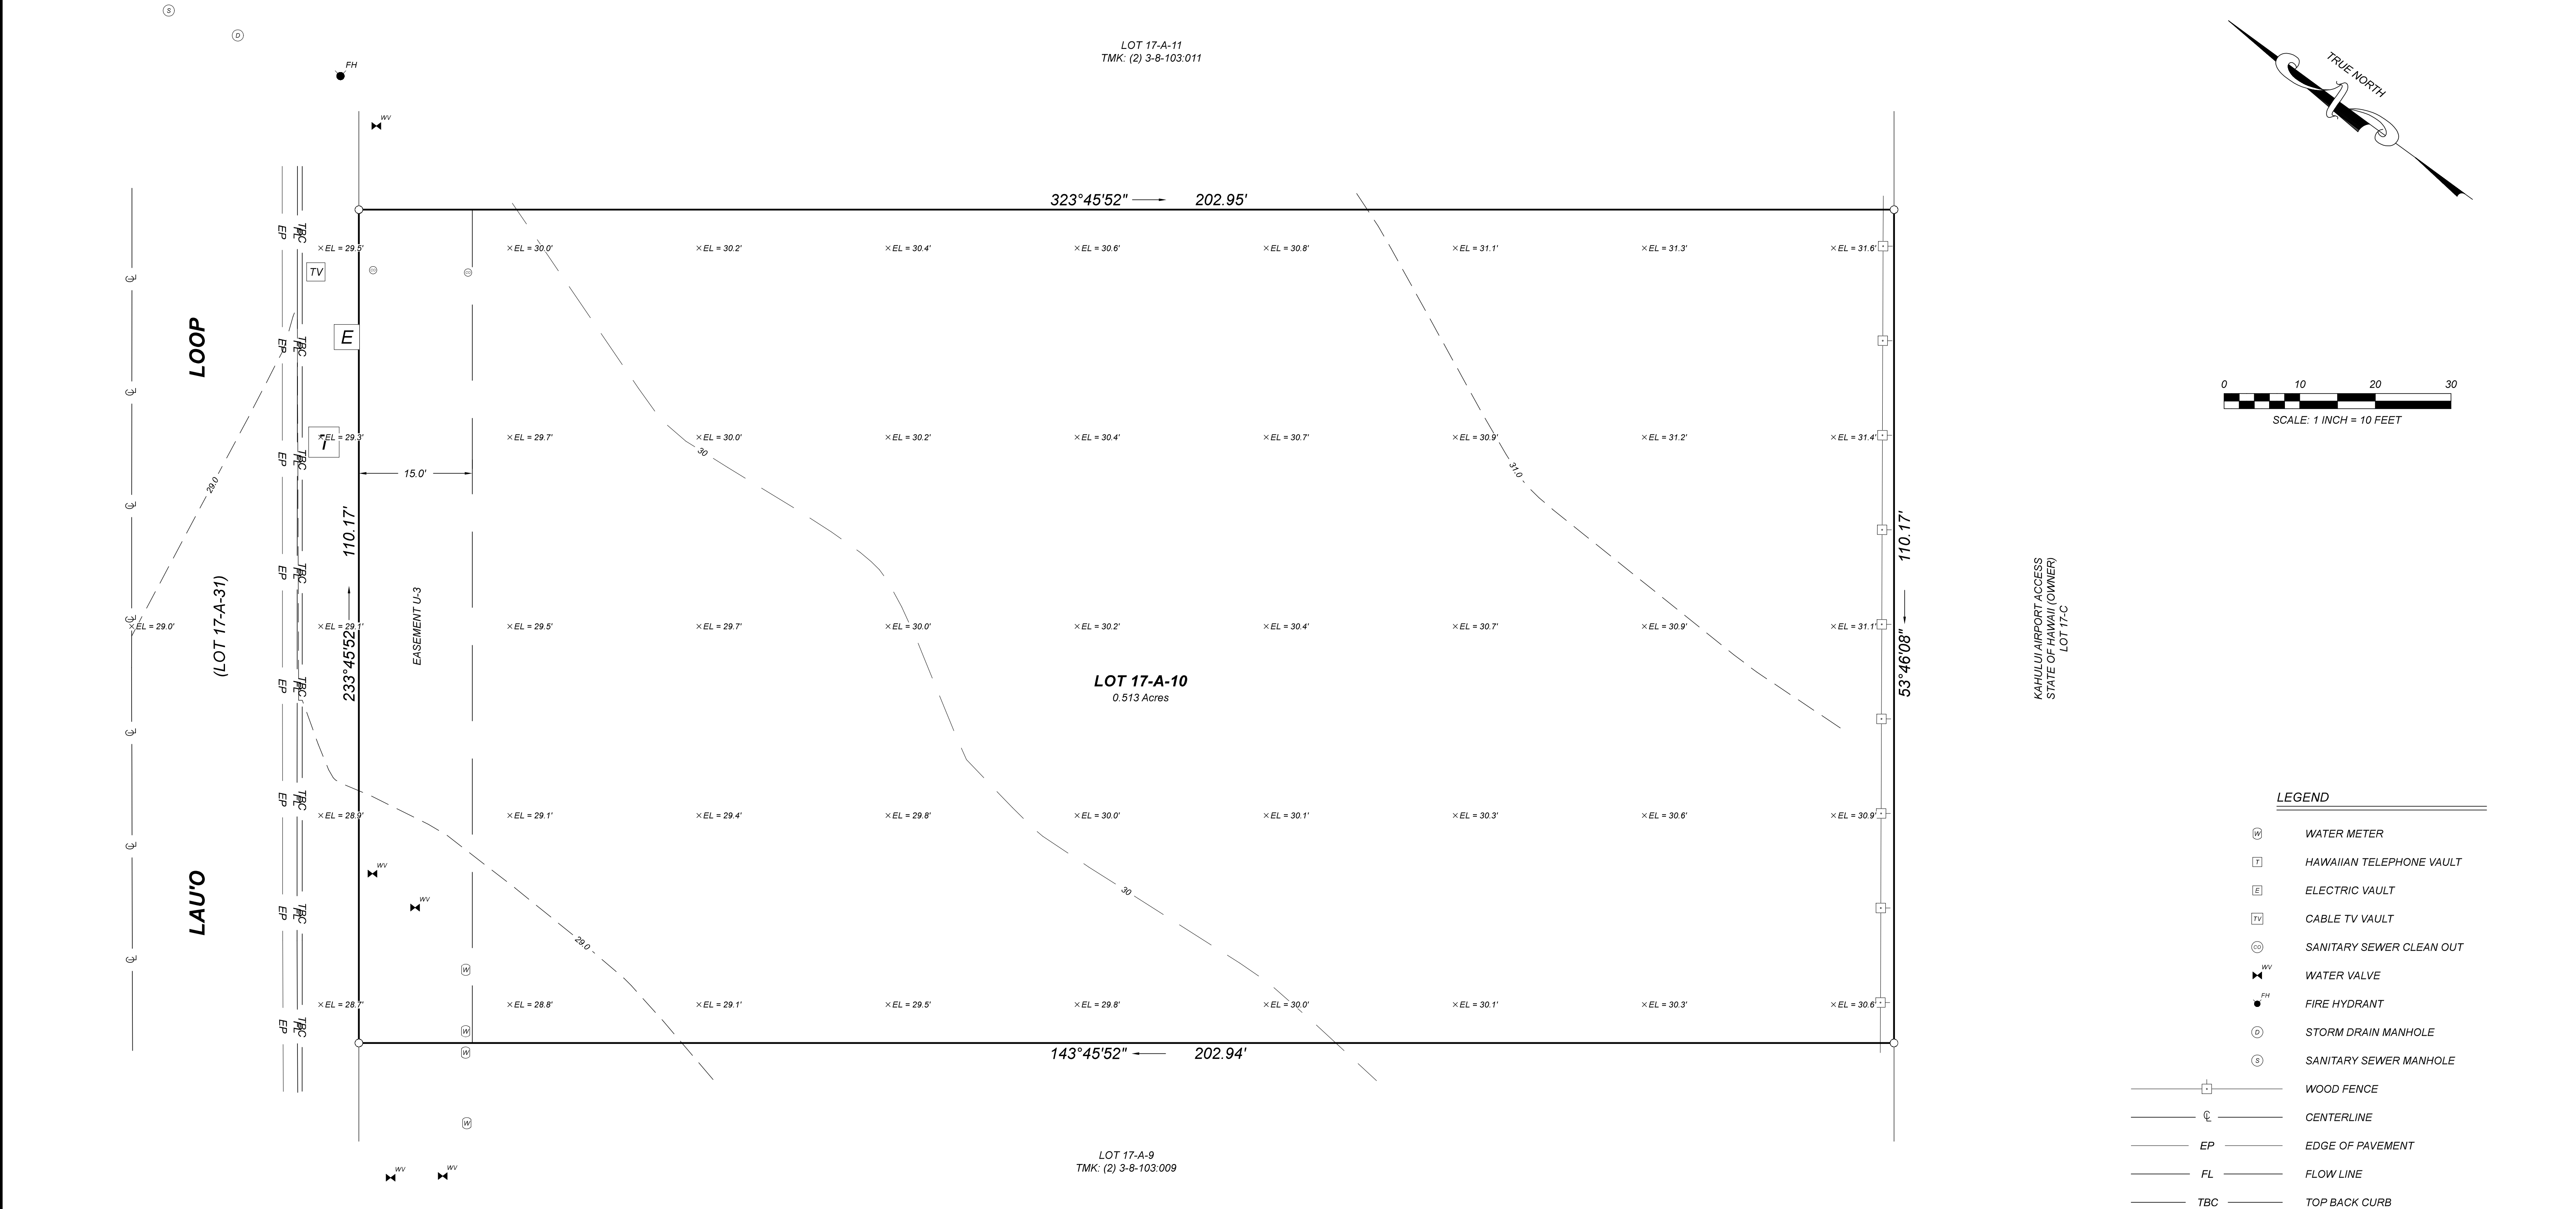


Prepared For :
Imua Energy LLC
bking@biodesel.com

NOTES:
1. 1/2" pipes were found at all boundary corners unless noted otherwise.
2. Elevations are based on construction plans signed by D. Trang Nguyen (Licensed Professional Engineer) with Austin, Tsutsumi & Associates, INC, Dated October 2011.
3. Easement U-3, for utility and waterline purposes in favor of A & B Properties, Inc.
4. This map is based on an actual field survey performed on August 26, 2022.

ACTION
SURVEY
Hawaii

Action Survey LLC
P.O. Box 2985 Wailuku, HI 96793
Office: (808) 891-2400 Fax: (808) 879-2402
E-Mail: info@actionsurveyhawaii.com
Website: www.cdfengineers.com

TOPOGRAPHIC SURVEY OF LOT 17-A-10
AIRPORT INDUSTRIAL SUBDIVISION
Subdivision File No. 3.2257
Being a portion of Grant 3343 to Claus Spreckels
situated at Kahului, Wailuku, Maui, Hawaii
T.M.K. (2) 3-8-103:010
Date: 09/01/2022

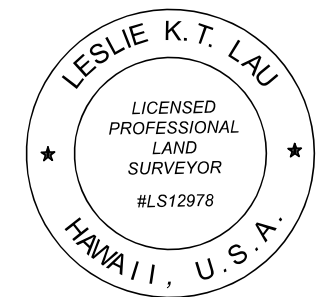

This map was prepared by me or under my direct supervision.
Leslie K.T. Lau
Registered Professional Land Surveyor
State of Hawaii Certificate Number LS12978
License Expiration Date: 30 April 2024