


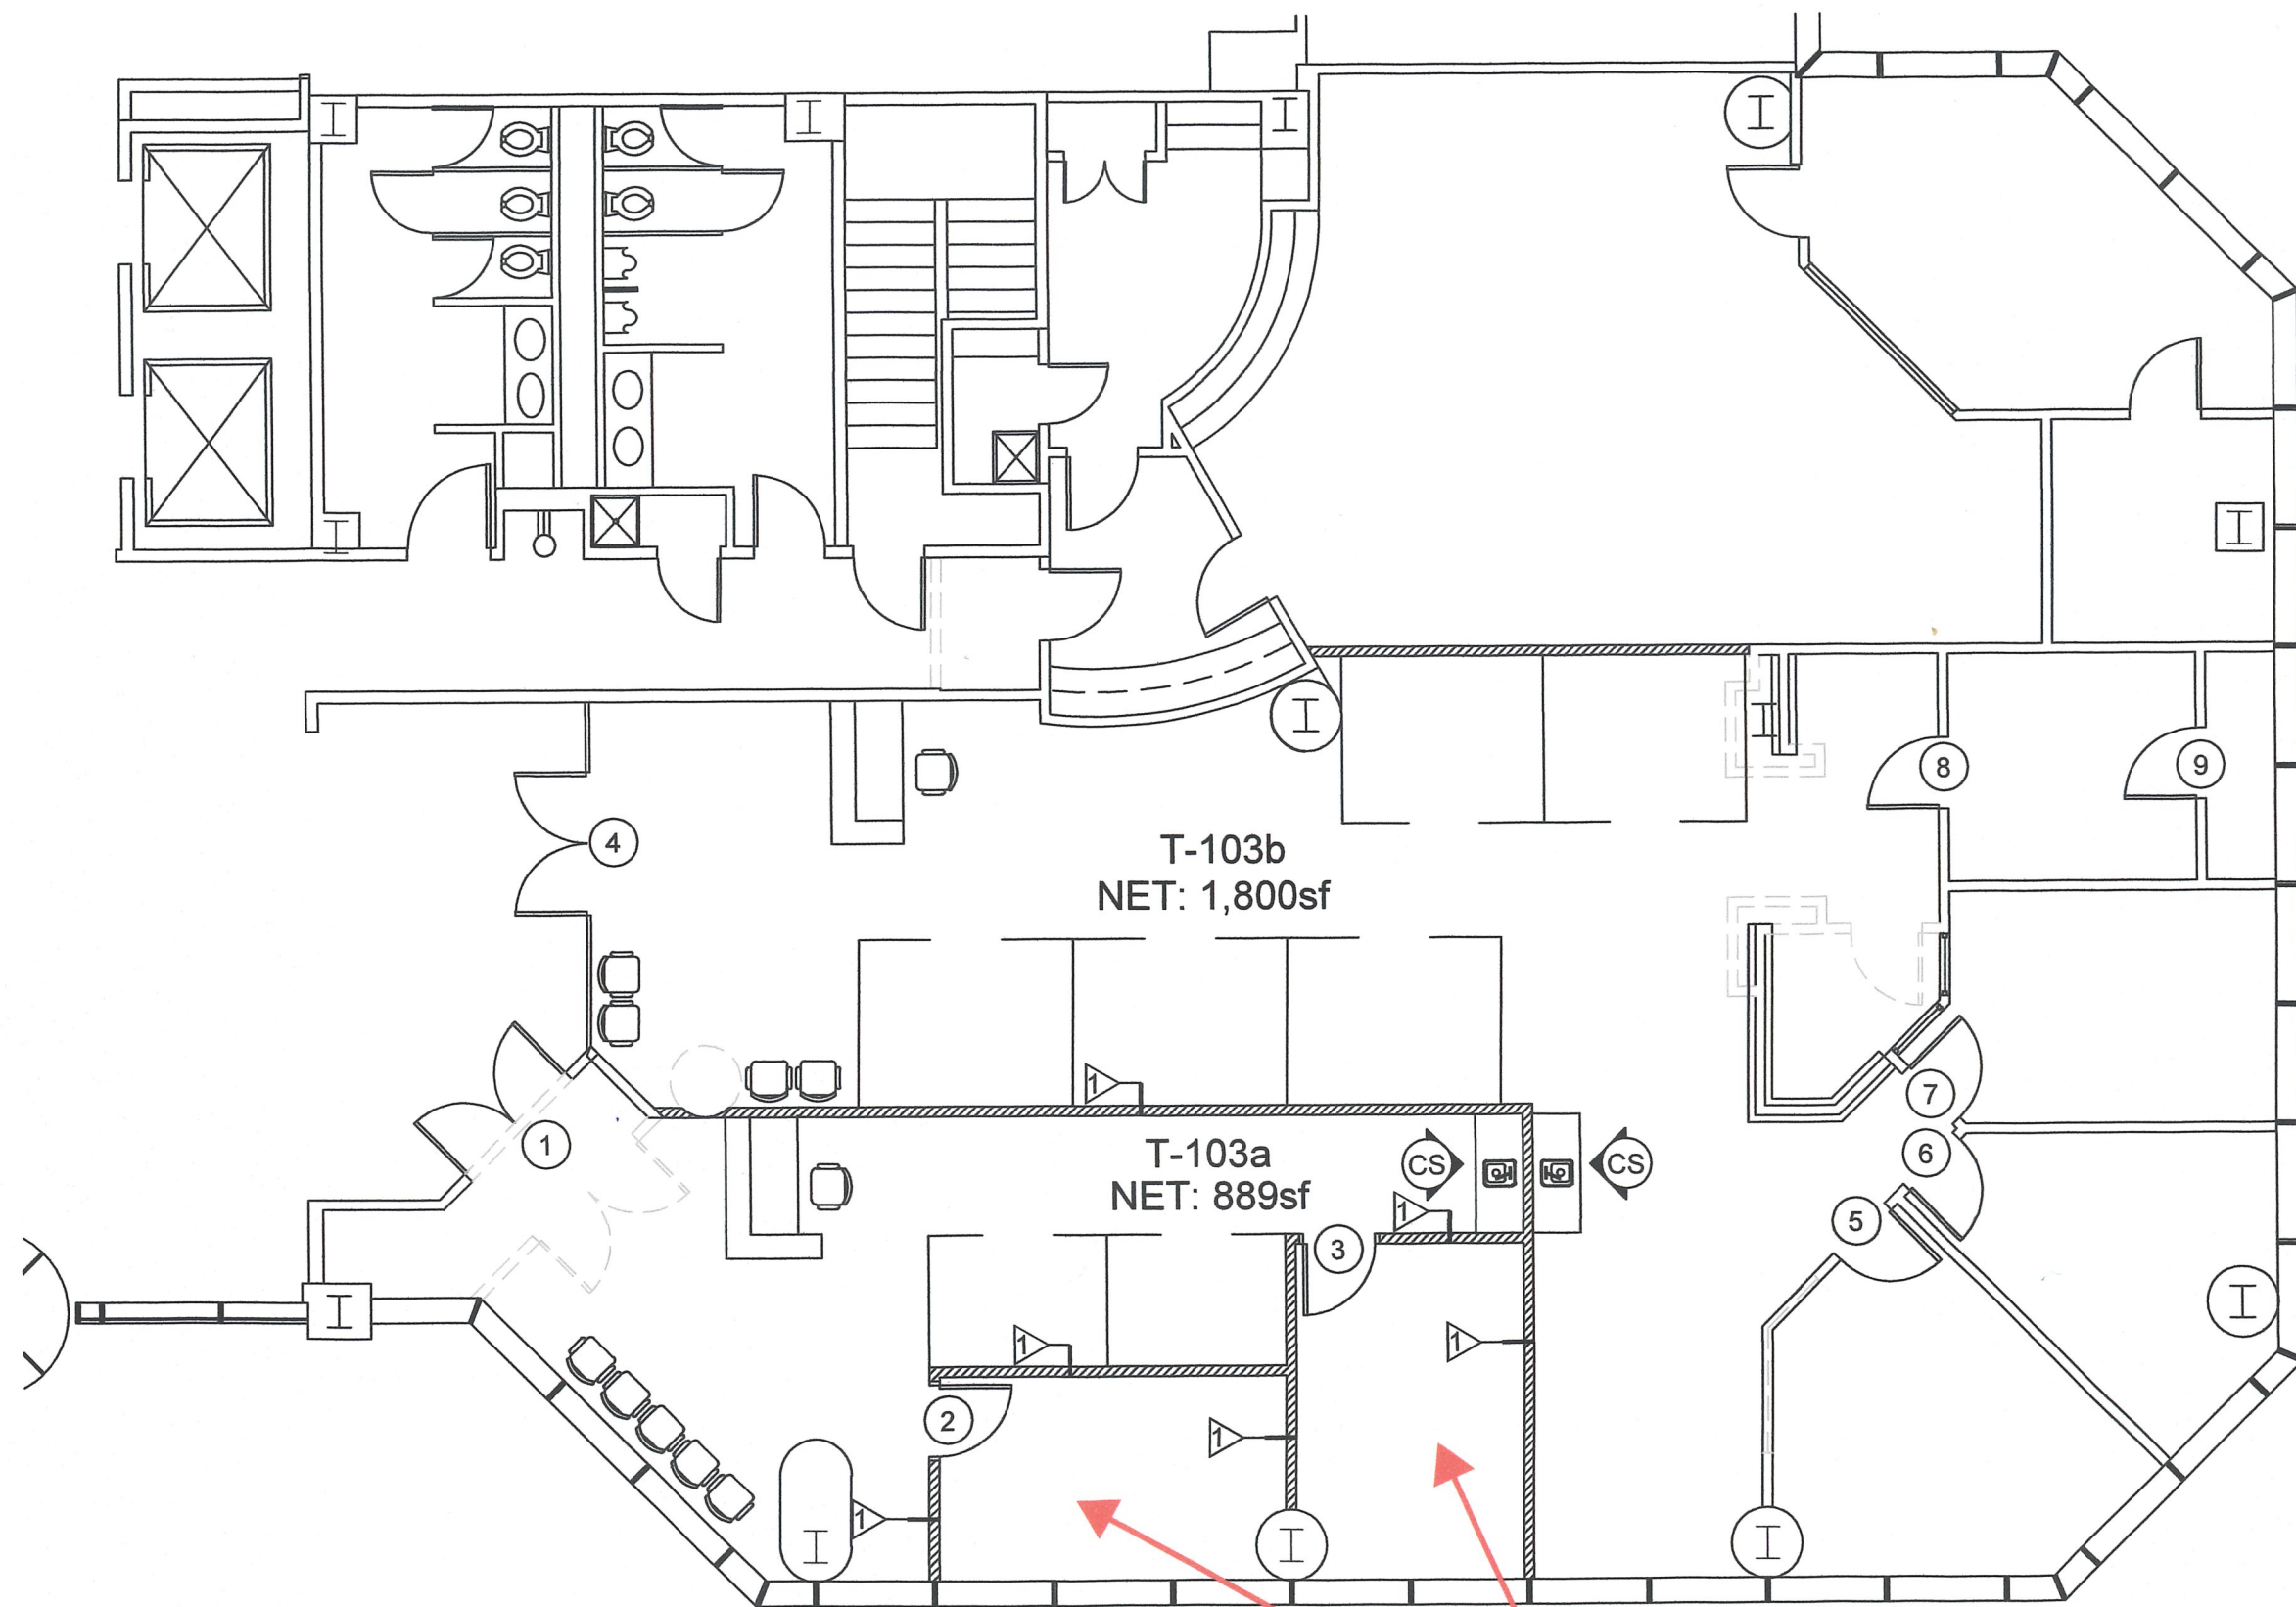

FLOOR PLAN

PLAN REVIEW COMMENT