



Suite 105
2440
Texas Parkway
Level 01

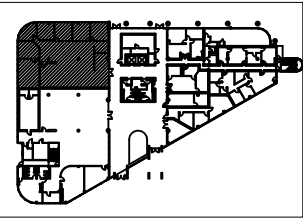

Suite Location:

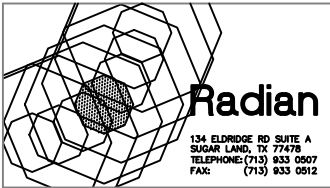

Suite Area:
4,981 NRSF
Project Number:
2194.CB
Scale:
1/8"=1'-0"
Sheet Number:

AB-105

