
[illegible]

MONUMENT LEGEND

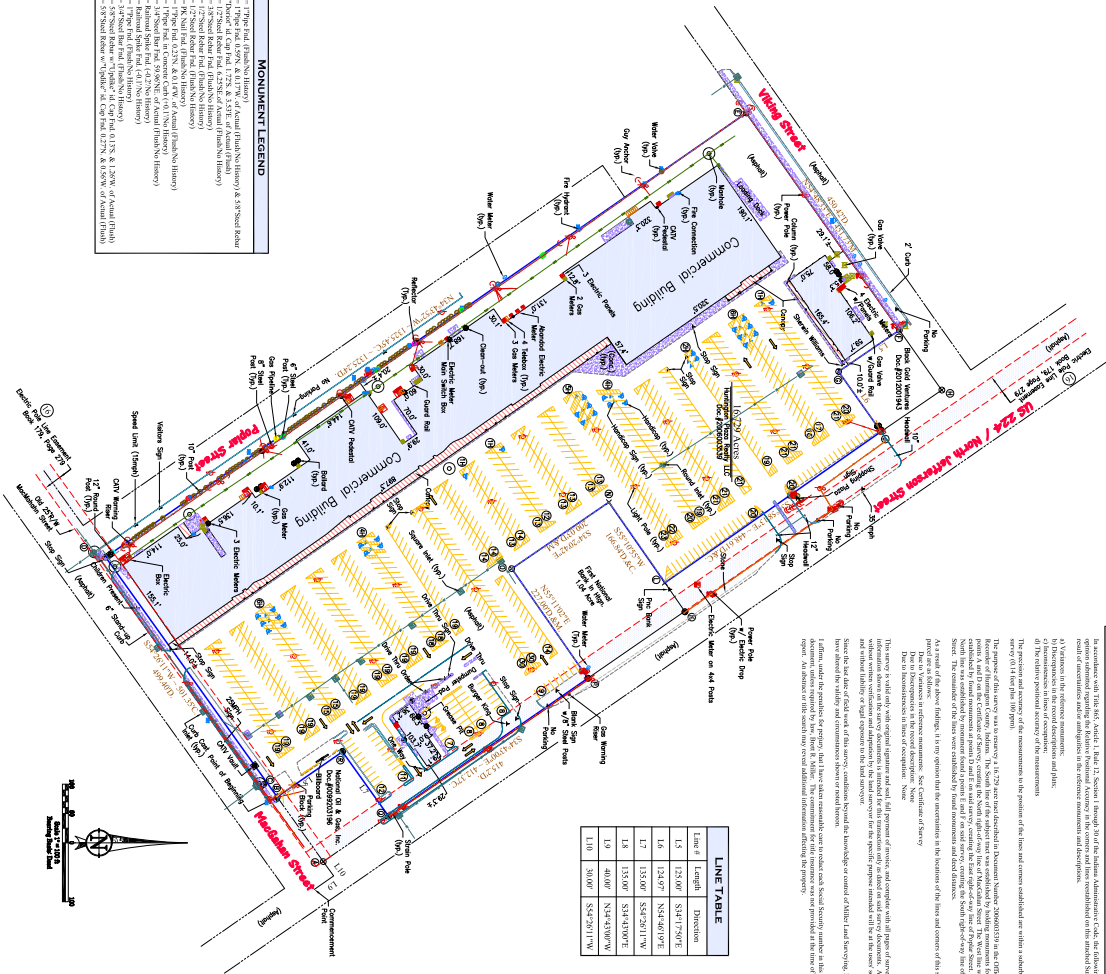

LINE TABLE		
Line #	Length	Direction
L.5	125.00'	S34°17'50"E
L.6	124.97'	N54°46'19"E
L.7	135.00'	S54°26'11"W
L.8	135.00'	S34°43'00"E
L.9	40.00'	N34°43'00"W
L.10	30.00'	S54°26'11"W

opinion submitted regarding the Relative Positional Accuracy in the corners and lines reestablished on this attached Survey as result of uncertainties and/or ambiguities in the reference monuments and descriptions.

The position and accuracy of the measurements to the position of the lines and corners established are within a subsection survey (0.14 sec plus 10 ppm).




This survey is valid only with original signature and seal. Full payment of invoice, and completion with all pages of survey. The information shown on the survey documents is intended as an indication only of what our end users document. Any creation or alteration of the survey documents without the express approval of the project sponsor renders void all the survey and its results and without liability or legal exposure to the end user(s).

Since the last date of field work, this survey, conclusions beyond the knowledge of studies of Miller Land Surveying, Inc., were directed by Millery and circumstances showed or could have been.

I affirm, under the penalties perjury, that I have taken reasonable care to obtain each Social Security number in this document verified by law. Thus, I declare. The commitment for the insurance was not provided at the time of this report. An affidavit or full survey will result additional investigation affecting the property.

United Properties Corp.
Huntington Plaza Realty LLC, a Delaware limited liability company

Commitment No. 471976
Commitment Date: June 16, 2014 at \$500m.

This is to certify that this map or plan and the survey on which it is based were made in accordance with the 2011 Minimum Standard Detail Requirements for ALTA/ACSM Land Title Surveys, jointly established and adopted by ALTA and NSRS, and includes items 1, 3, 4, 6a, 8, 11a, 13, 14, 16, 17 and 18 of Table A thereof. The field work was completed on July 15, 2014.

Date: July 18, 2014



County, Indiana, and being more particularly described as follows:

[illegible][illegible]

This property is within an unprinted area per FEMA website City of Huntington, Indian

This property is within an unprinted area per FEMA website City of Huntington, Indian

March 23, 1999

Legend

POB	- Point of Beginning
ME	- Measured
R	- Easement
C	- Calculated
D	- Deed
- Right of Way (R/W)	
- Building Setback Line	
- Center Line	