Eagle Lake Business Center III

7351 Kirkwood Ln N, Maple Grove

Suite 104 – Power

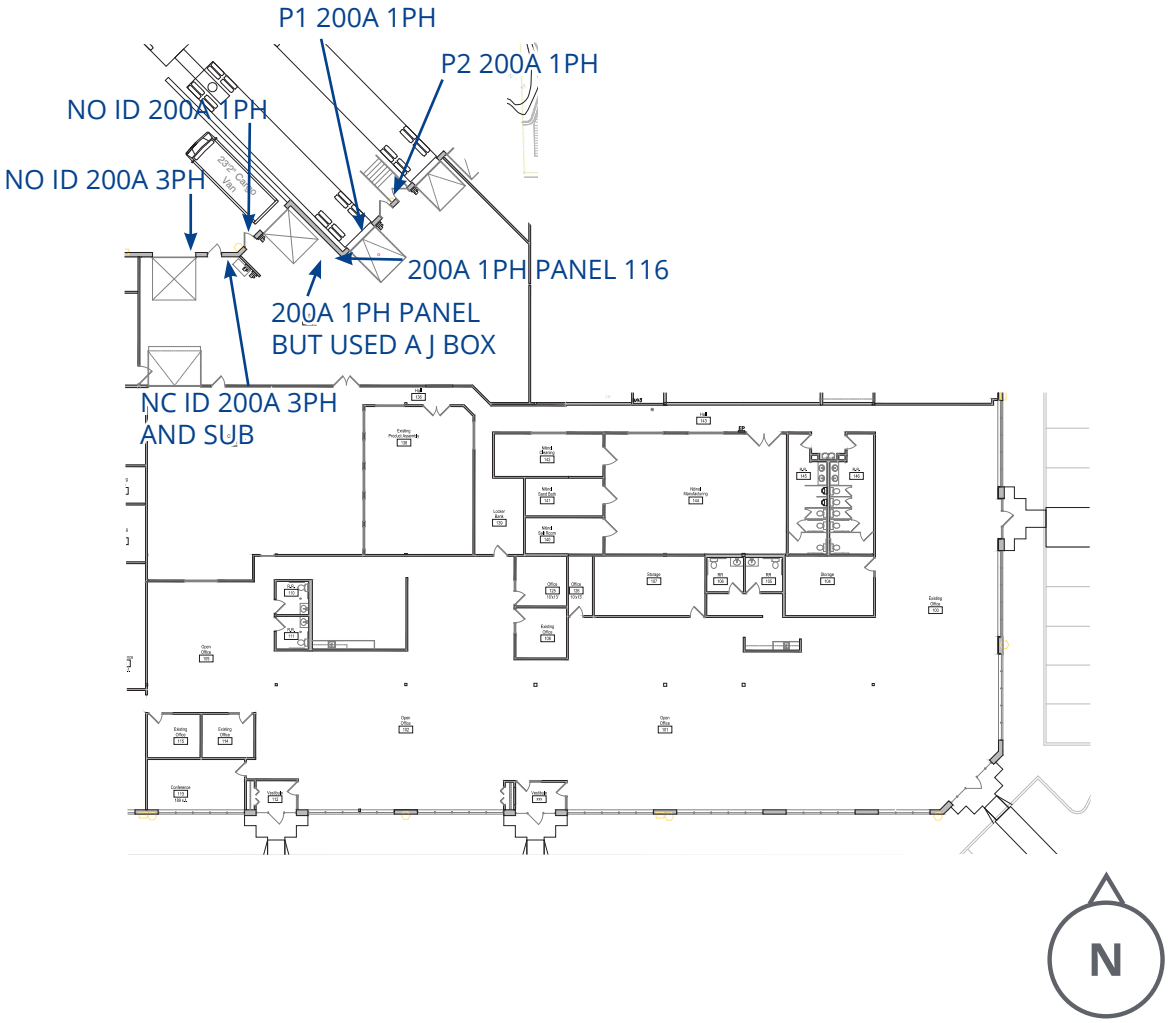

Colliers