


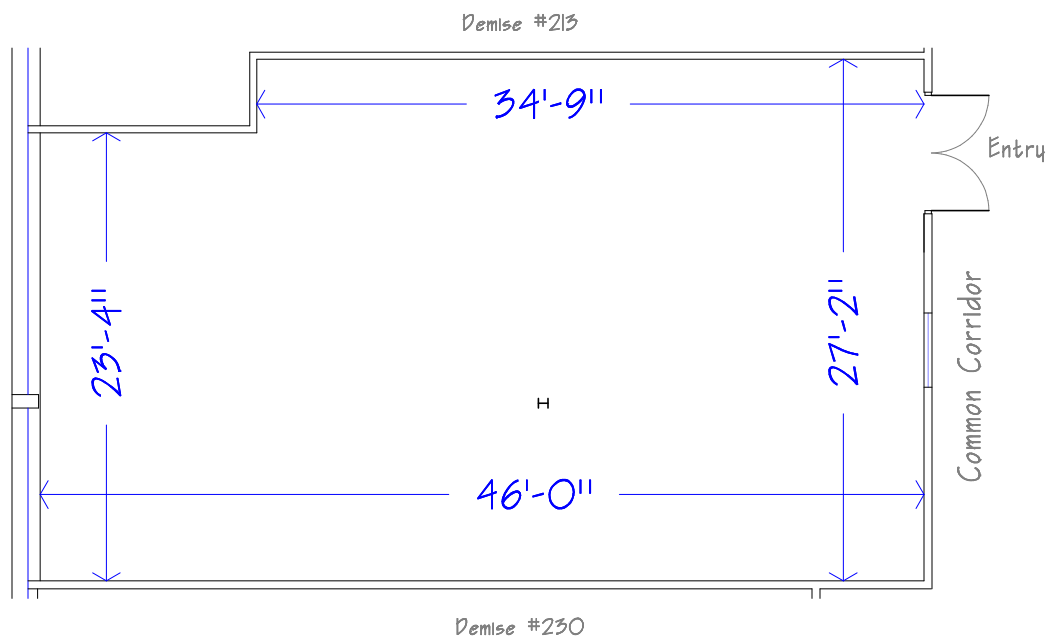

Suite 213B
2770 Dufferin Street

Toronto, Ontario

as measured January 23, 2026

