



For Leasing Information Call:
Gillett Properties, Ltd. 713 532 5353

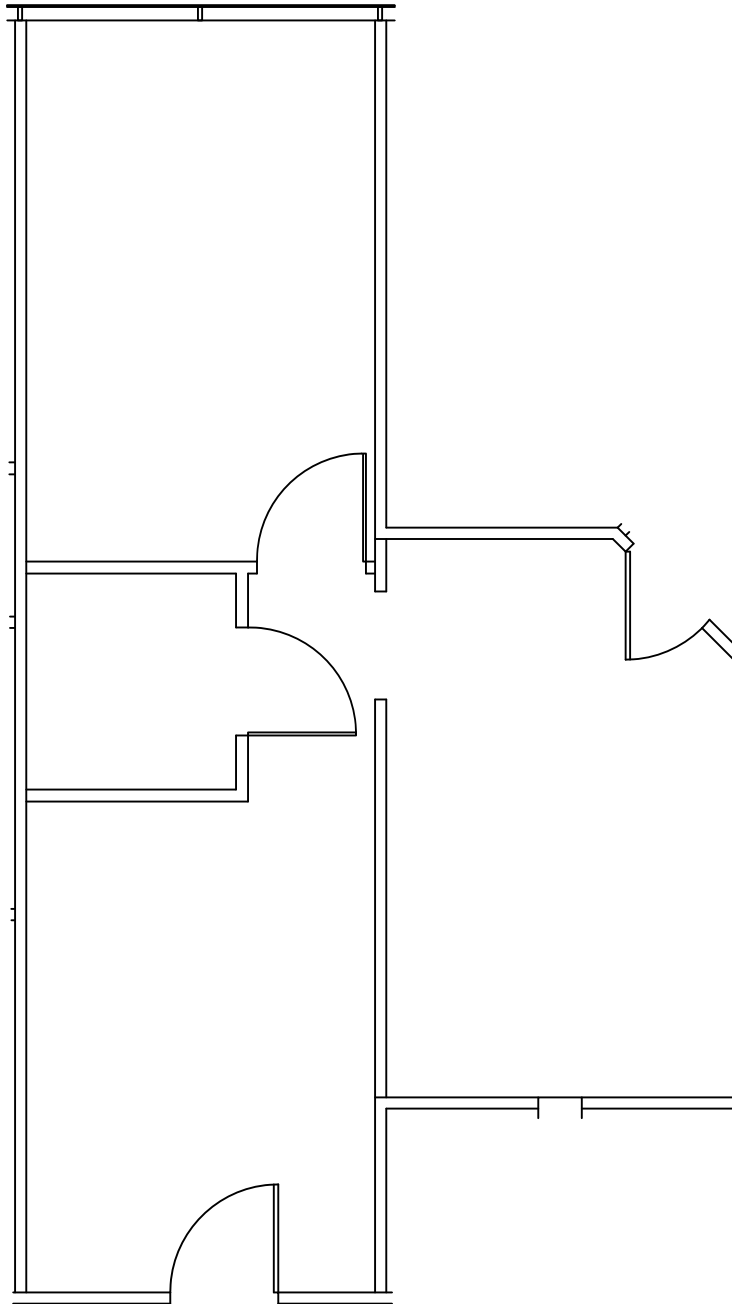

10.29.21

Suite 217
2440
Texas Parkway
Level 02

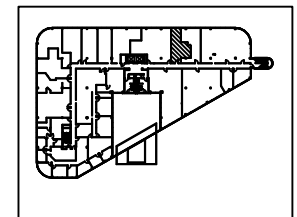

Suite Location:



Suite Area:

608 NRSF

Project Number:

2194.CB

Scale:

3/16"=1'-0"

Sheet Number:

AB-217