


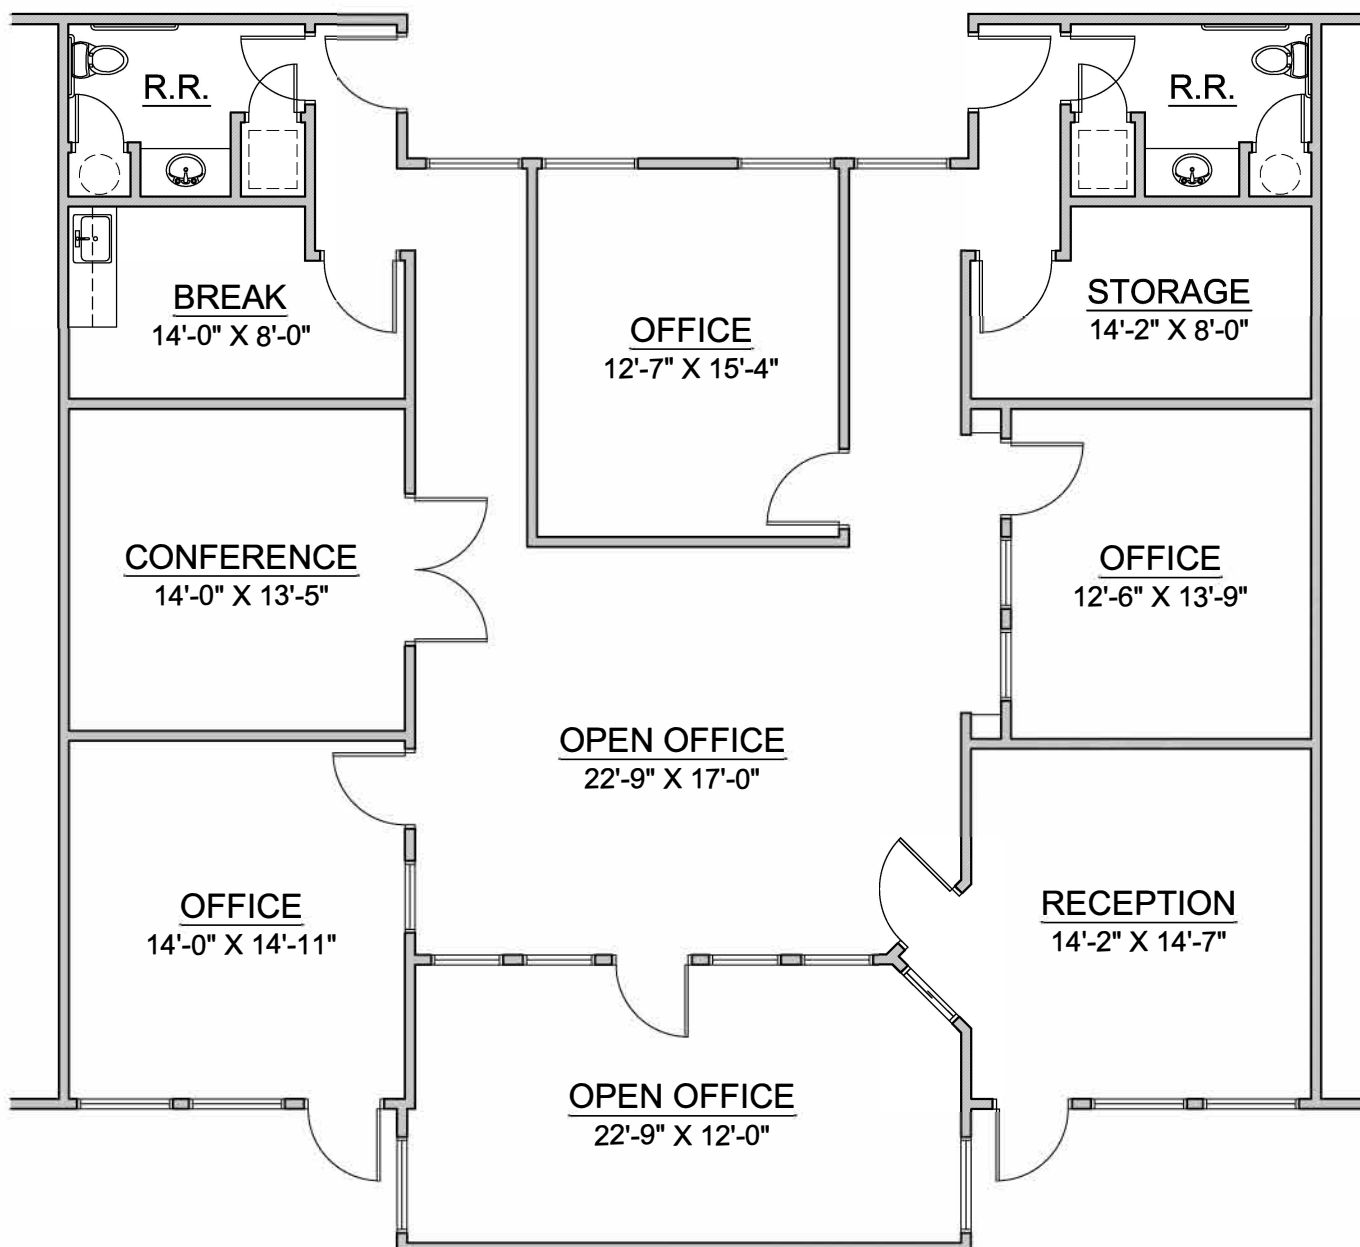

CONTACT: GRANT GOMEZ
214-734-4725

grant@txreproperties.com

JUSTIN SMITH
214-207-7173

jsmith@txreproperties.com



AN AS BUILT FOR:
1140E-F WEST PIONEER PARKWAY
ARLINGTON, TX 76013 2,400 SF

Kevin Simon

903.880.6636
kevinpsimon@me.com