




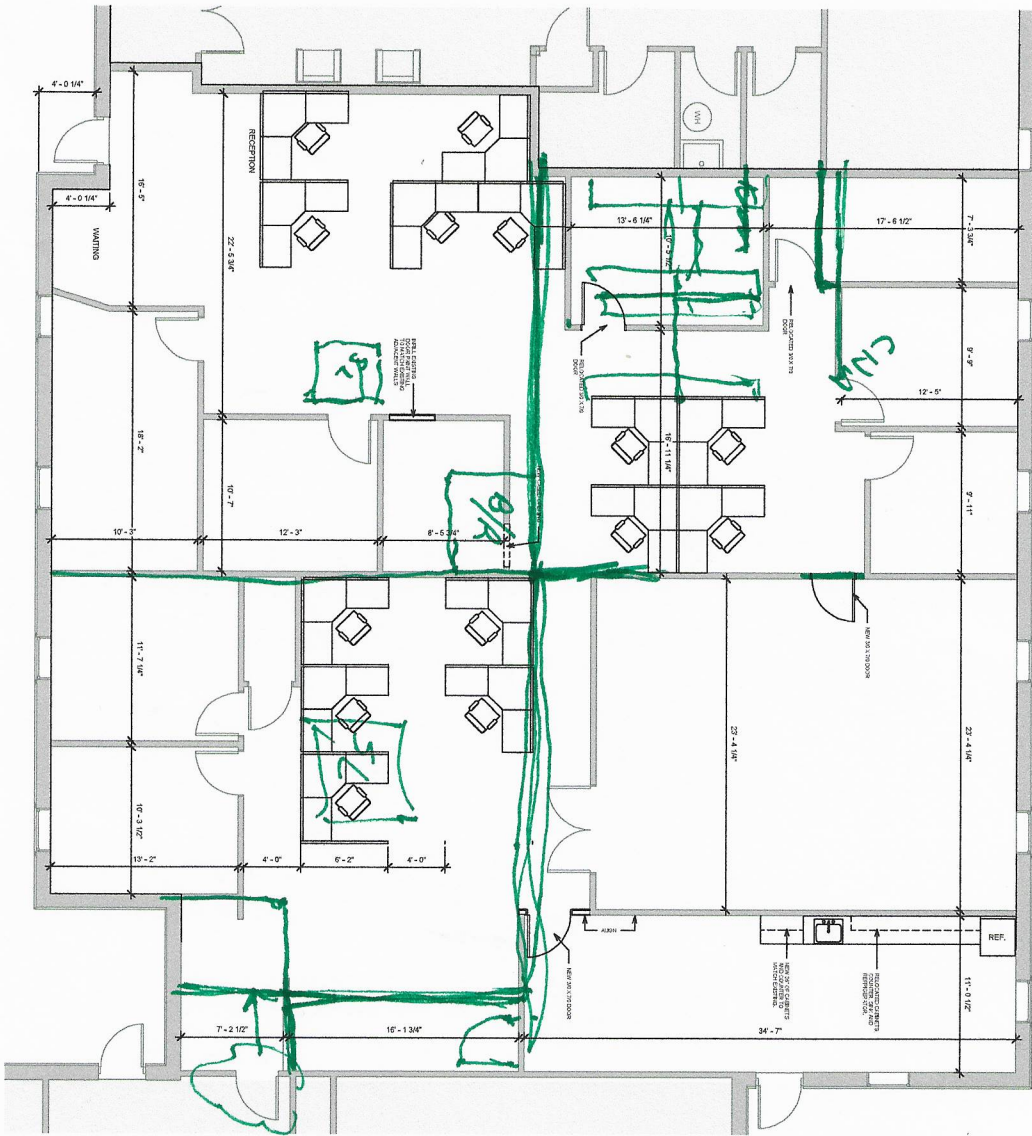

1/8" = 1'-0"

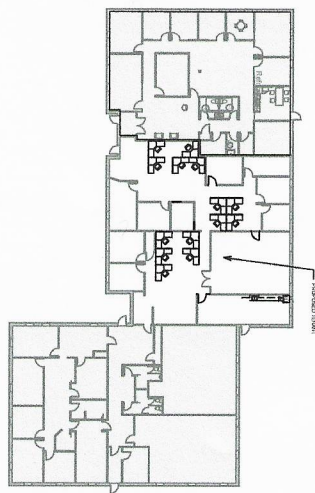

PROJECT NORTH

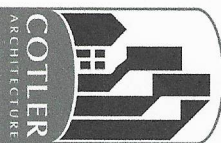

901 LOCUST ST. SUITE 100
PHILADELPHIA, PA 19106
WWW.COTLERARCHITECTURE.COM

PROJECT: PROPOSED FIT-UP
1100 N. 1ST ST.

PROPOSED
MASCENTRA HEALTH

DESIGNED BY: ASHLEY
DRAWN BY: JMS
CHECKED BY: JMS
DATE: 08/01/19

OWNER'S NOTES: 08/01/19

4987

A100