



TOTAL SF AVAILABLE -1,876 RSF (16%)

[Click to access 3D model](#)

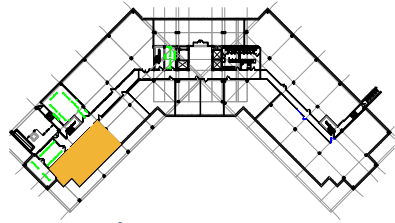

Key Plan

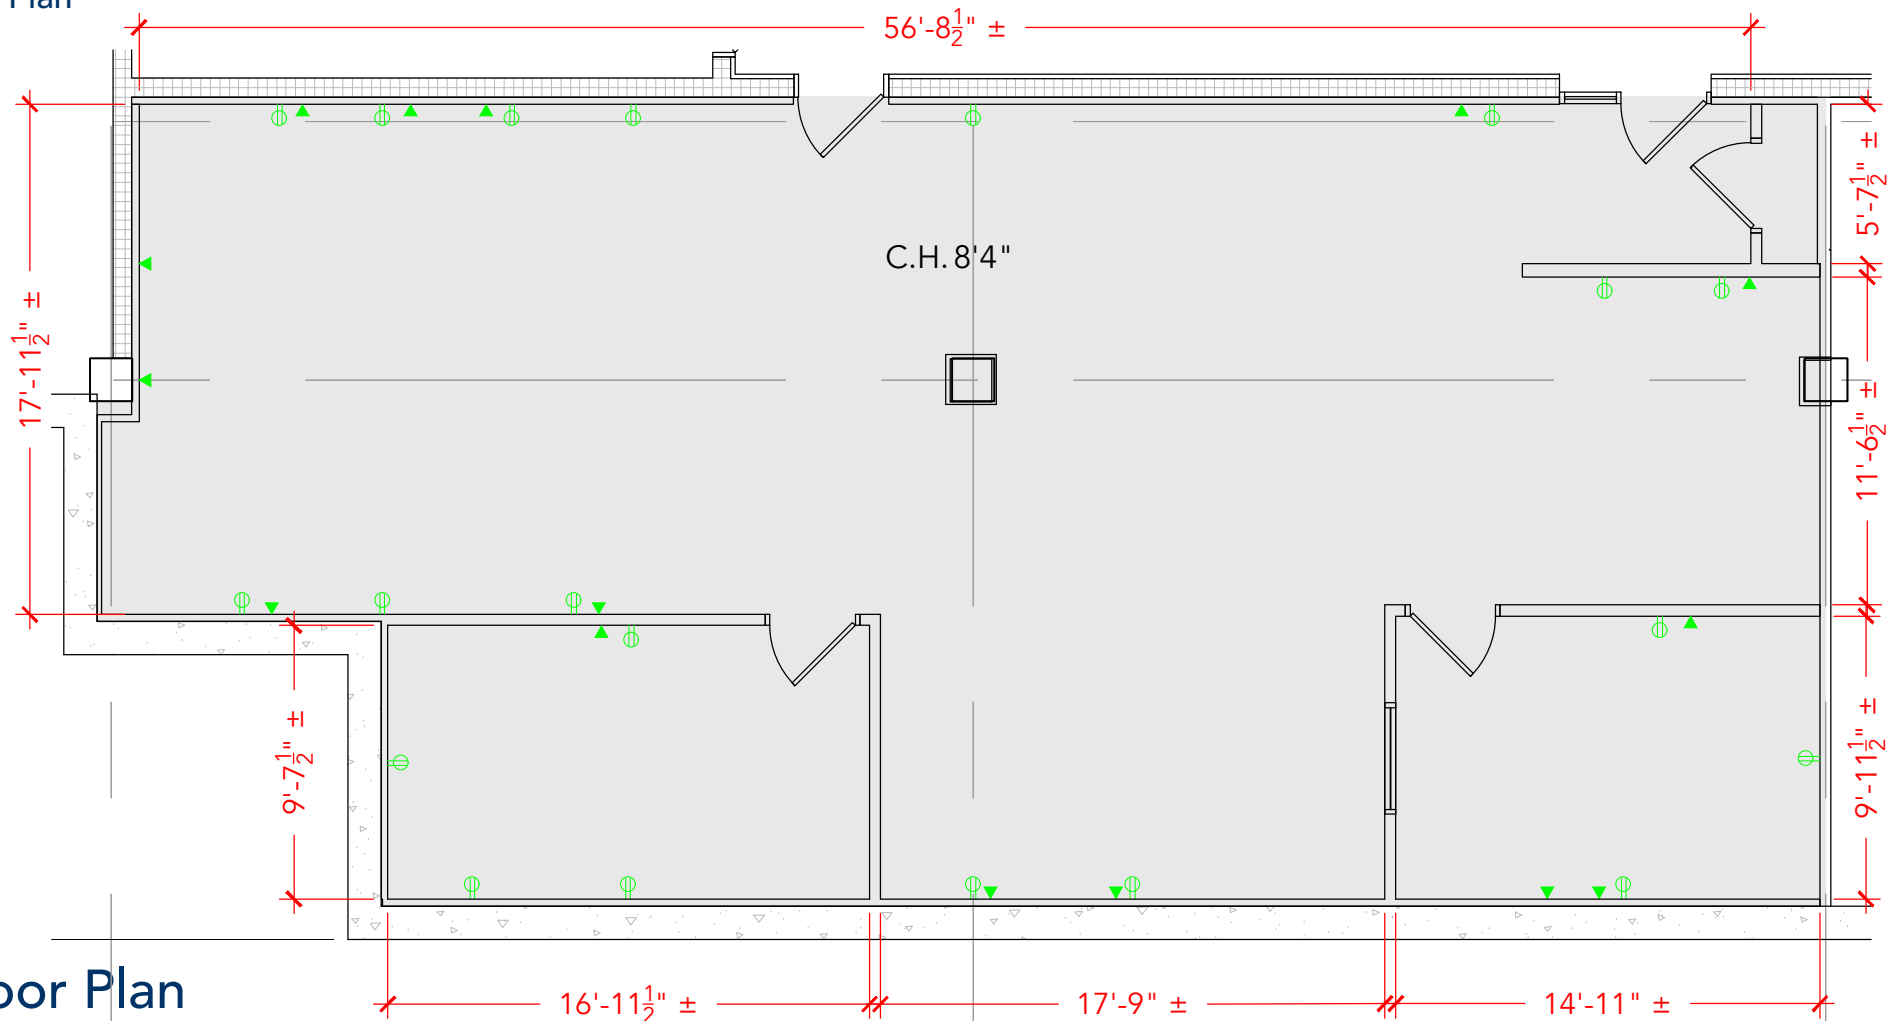

Floor Plan