


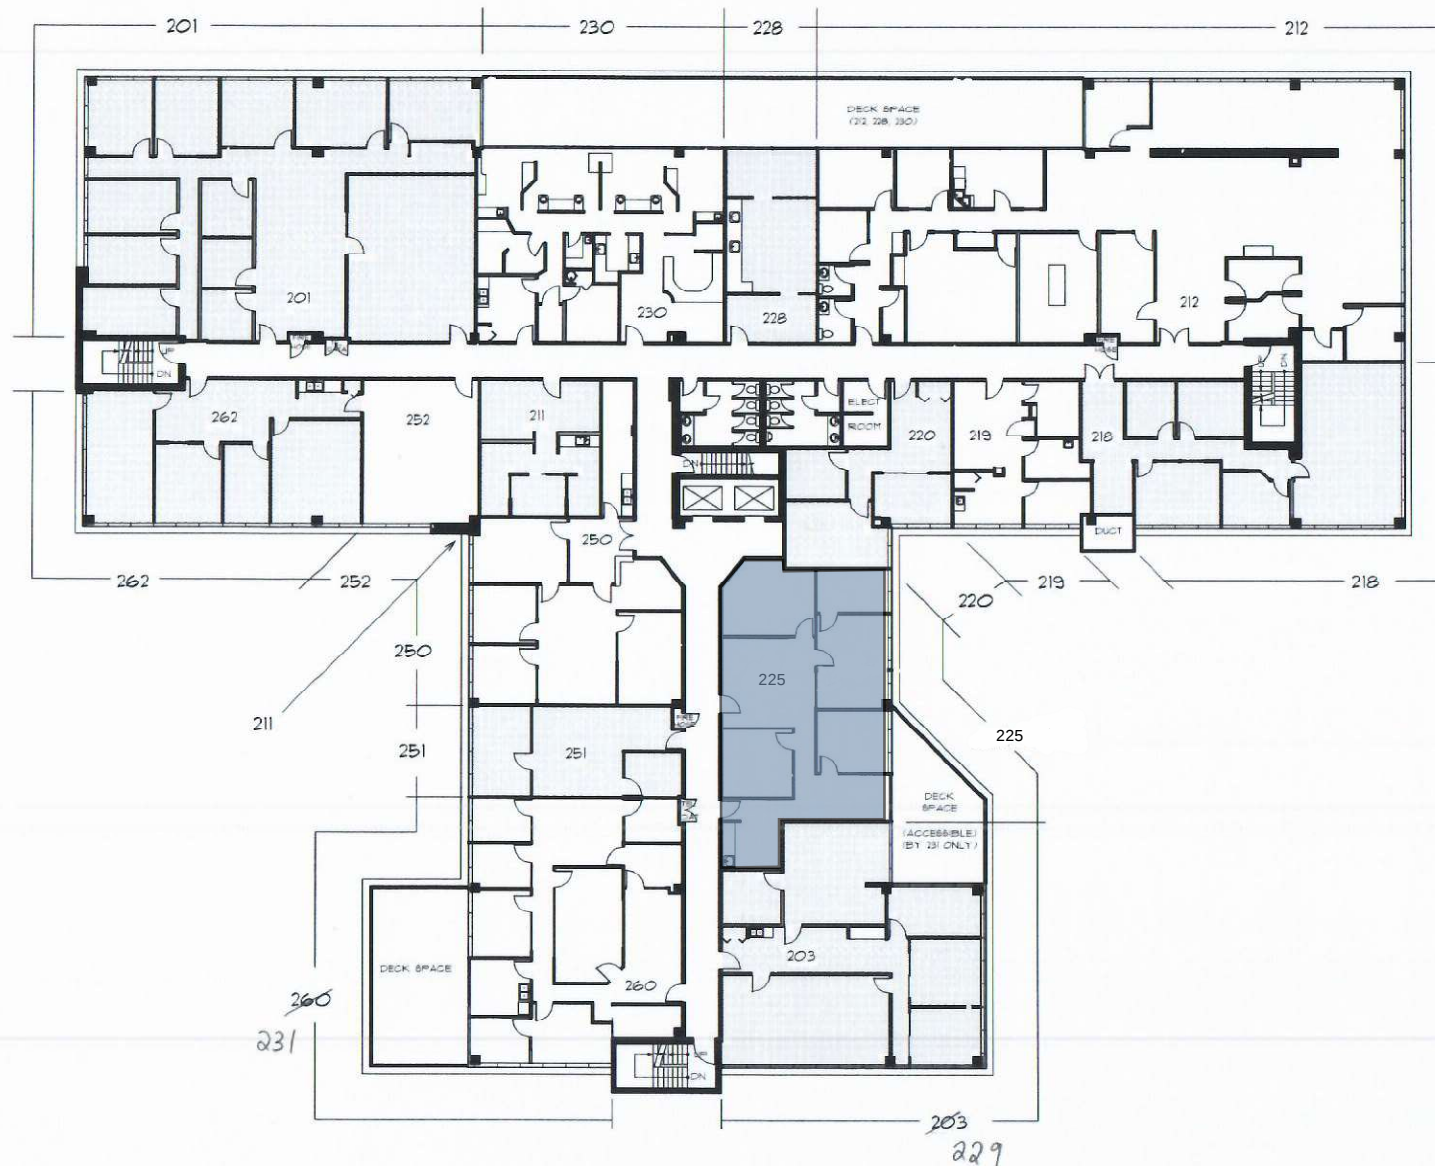

DATE	REVISION DETAIL
OCT 16, 2014	FILL COLOUR ERASED FROM PARTITION WALLS; SUITE 252 WAS 255. AMENDED NOTE TO INCLUDE BOMA 2010 REFERENCE.



NOTE:

1. AREA MEASUREMENTS ARE IN ACCORDANCE WITH ANSI/BOMA Z65.1-1996 AND WITH ANSI/BOMA Z65.1-2010.

BOUNDARY PLAZA
3665 KINGSWAY
2nd FLOOR
VANCOUVER BC

DRAWN BY: GERRY PARSONS
BOMA CALGARY CERTIFIED TECHNICIAN



OCTOBER 14, 2014

0 10 20 30 40 50



FEET



the Parsons Group
Delta BC
604-512-1203
www.theparsonsgroup.ca