


Main Floor

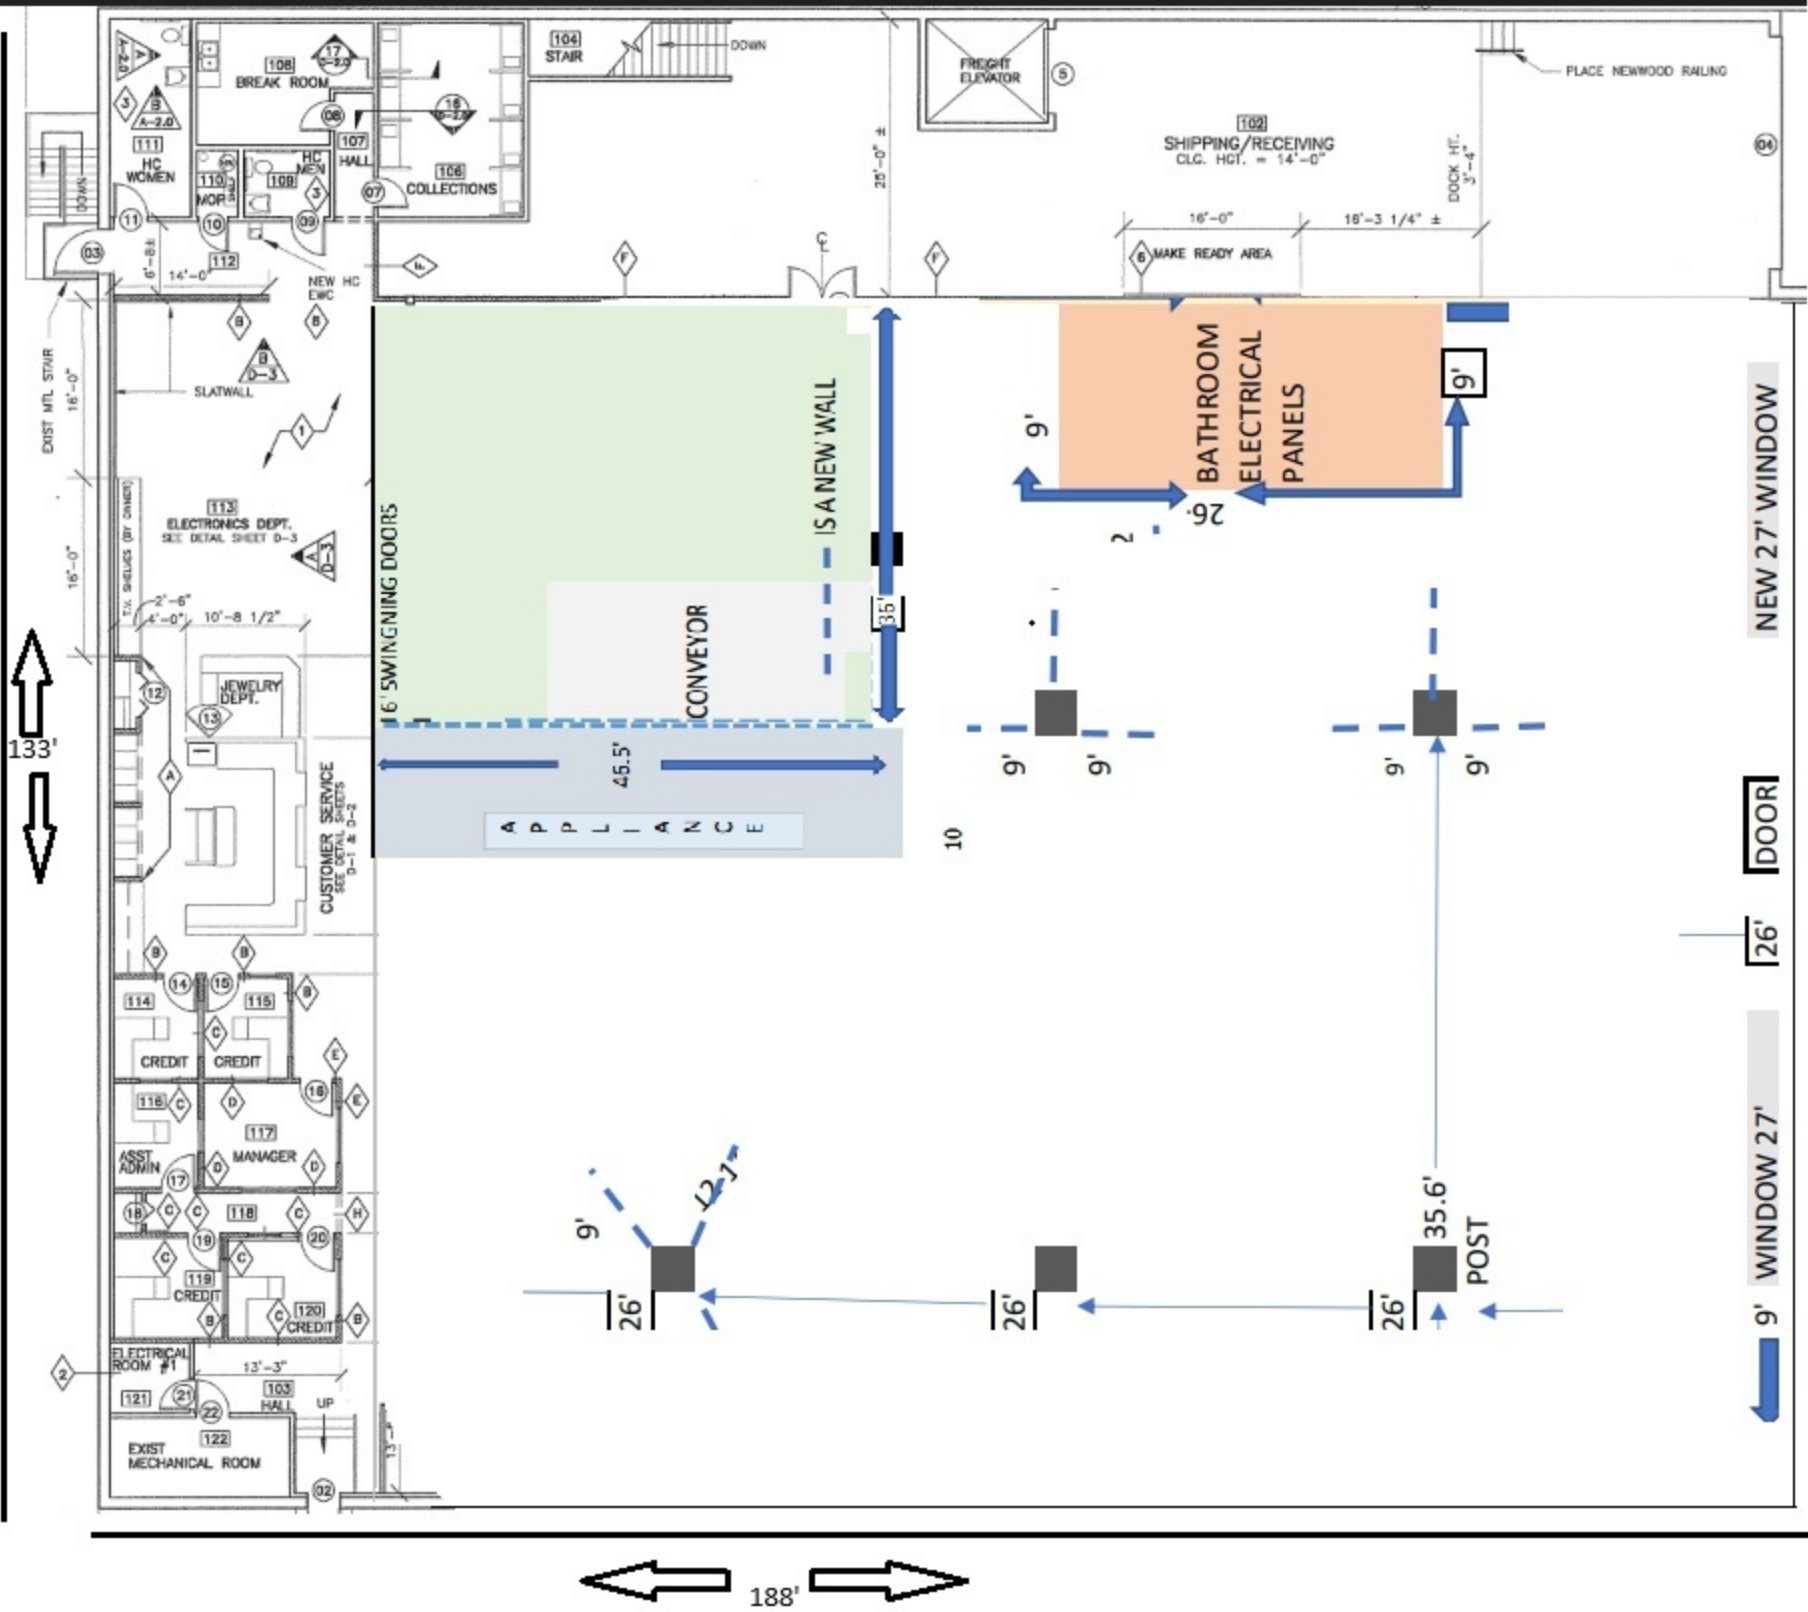

← 125' → Exterior Door

BASEMENT

S
T
A
I
R
S

S
T
A
I
R
S

Service
Elevator

↑
188'
↓