


1054 31st Street NW (Canal Square)  
First Floor **OPTION B**

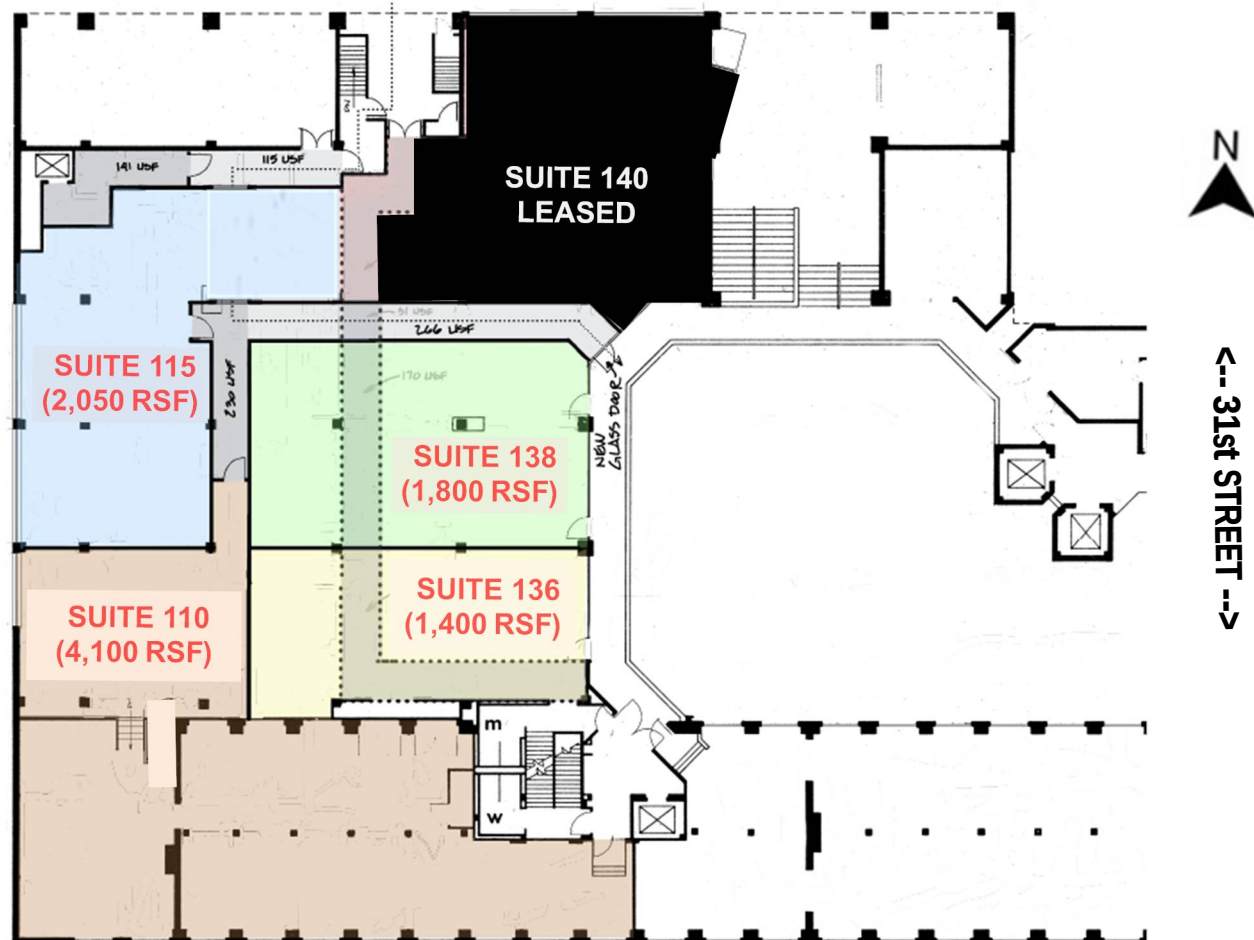


C&O CANAL

IMAGE AND SIZES ARE APPROXIMATE

5/29/2024

1054 31st Street NW (Canal Square)  
First Floor **OPTION D**

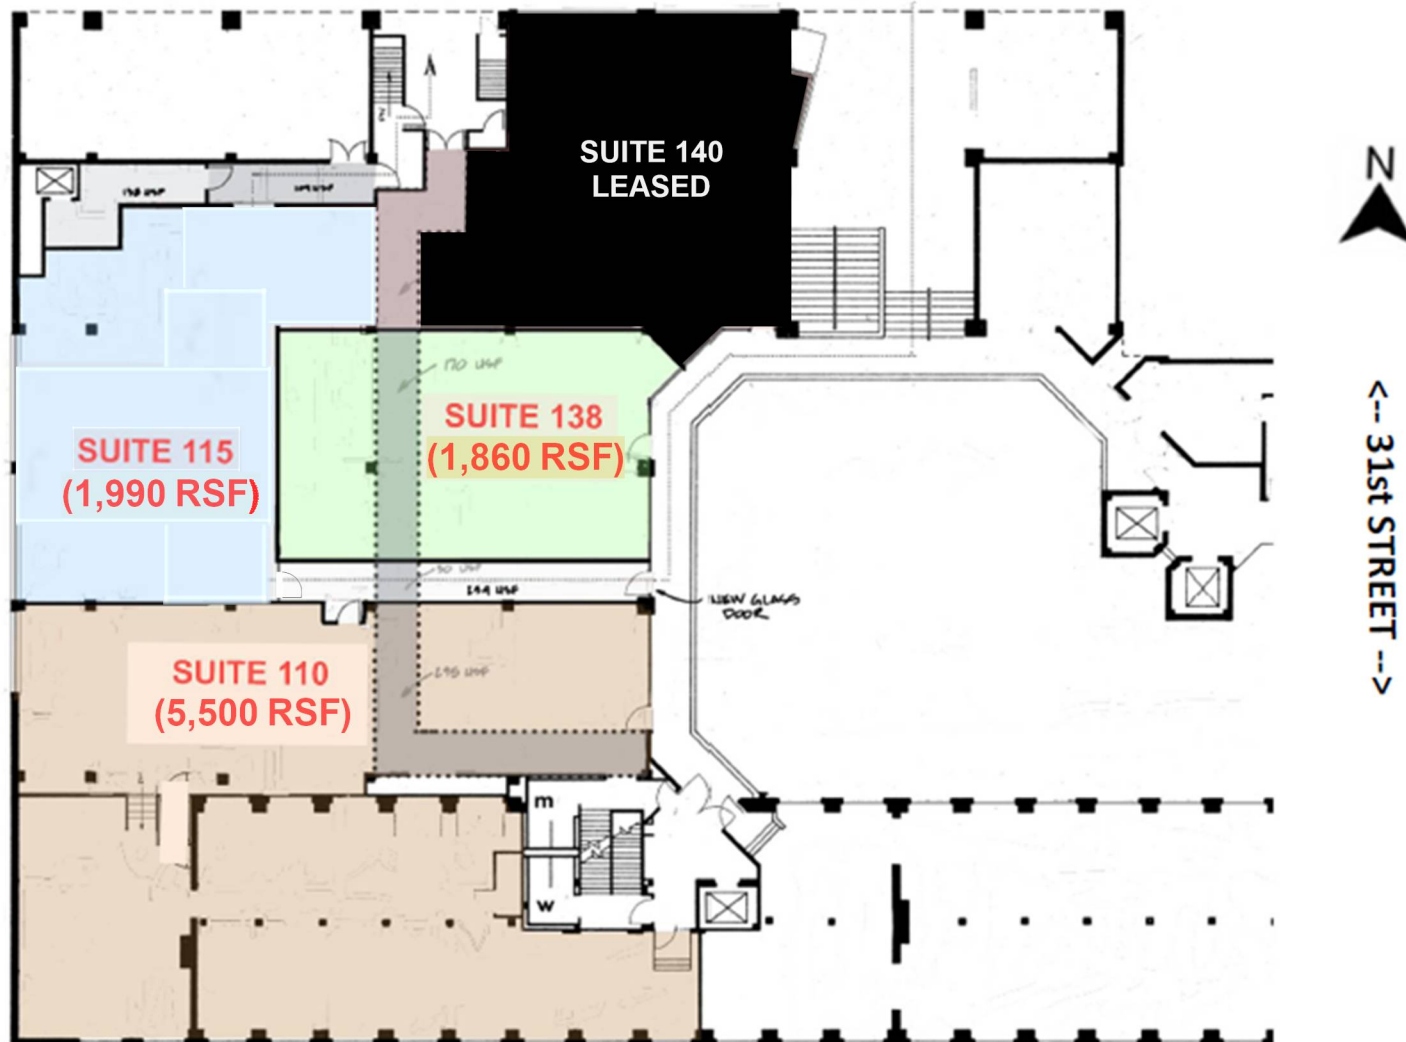

C&O Canal

IMAGE AND SIZES ARE APPROXIMATE  
5/29/2024