


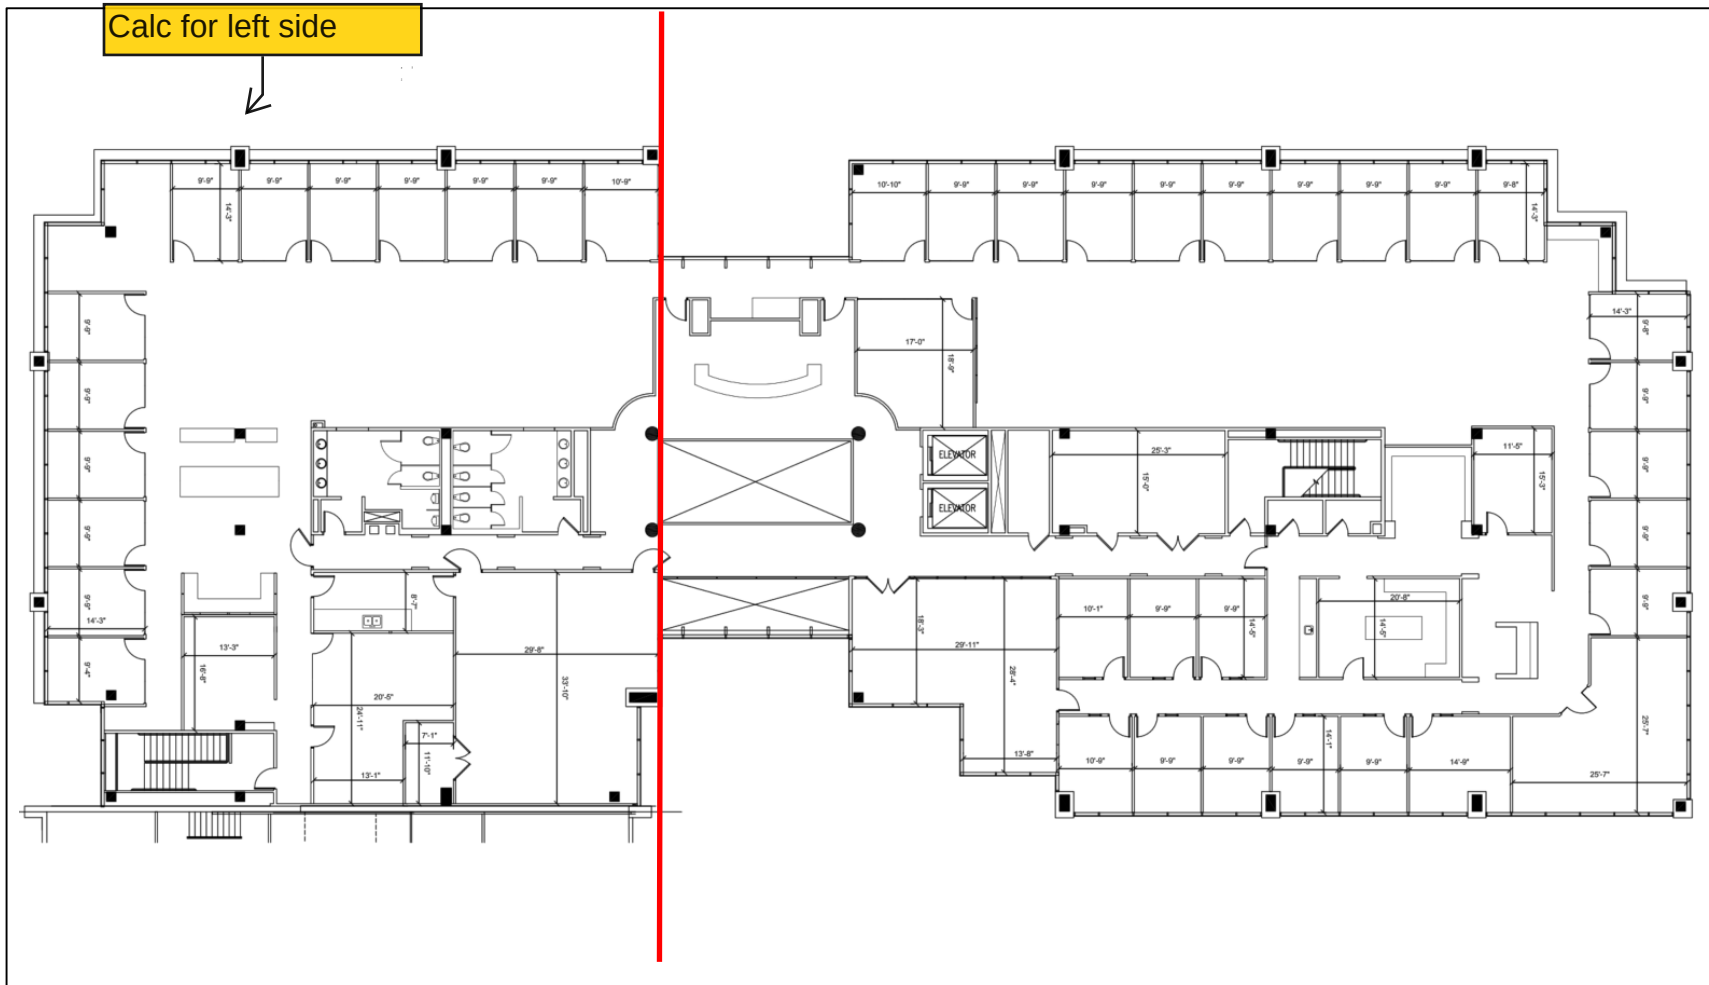

LEASING CONTACT:

Kolby Dickerson
kdickerson@txreproperties.com
214-534-1599

Grant Gomez
grant@txreproperties.com
214-734-4725

The Atrium on Collins
1701 N. Collins Blvd., Richardson,
TX 75080

Suite 3000 - 20,227 RSF



V-1

ALL DIMENSIONS AND SQUARE FOOTAGE CALCULATIONS NOTED ON THIS DOCUMENT ARE PRELIMINARY/ NON BINDING AND MUST BE FIELD VERIFIED FOR A TRUE AND ACCURATE REPRESENTATION.