


Floor Plan

BUILDING TOTALS	
TOTAL BUILDING	77,438 S.F.
LOWER LEVEL	-5,838 S.F.
FIRST FLOOR PLAN	71,600 S.F. GROSS

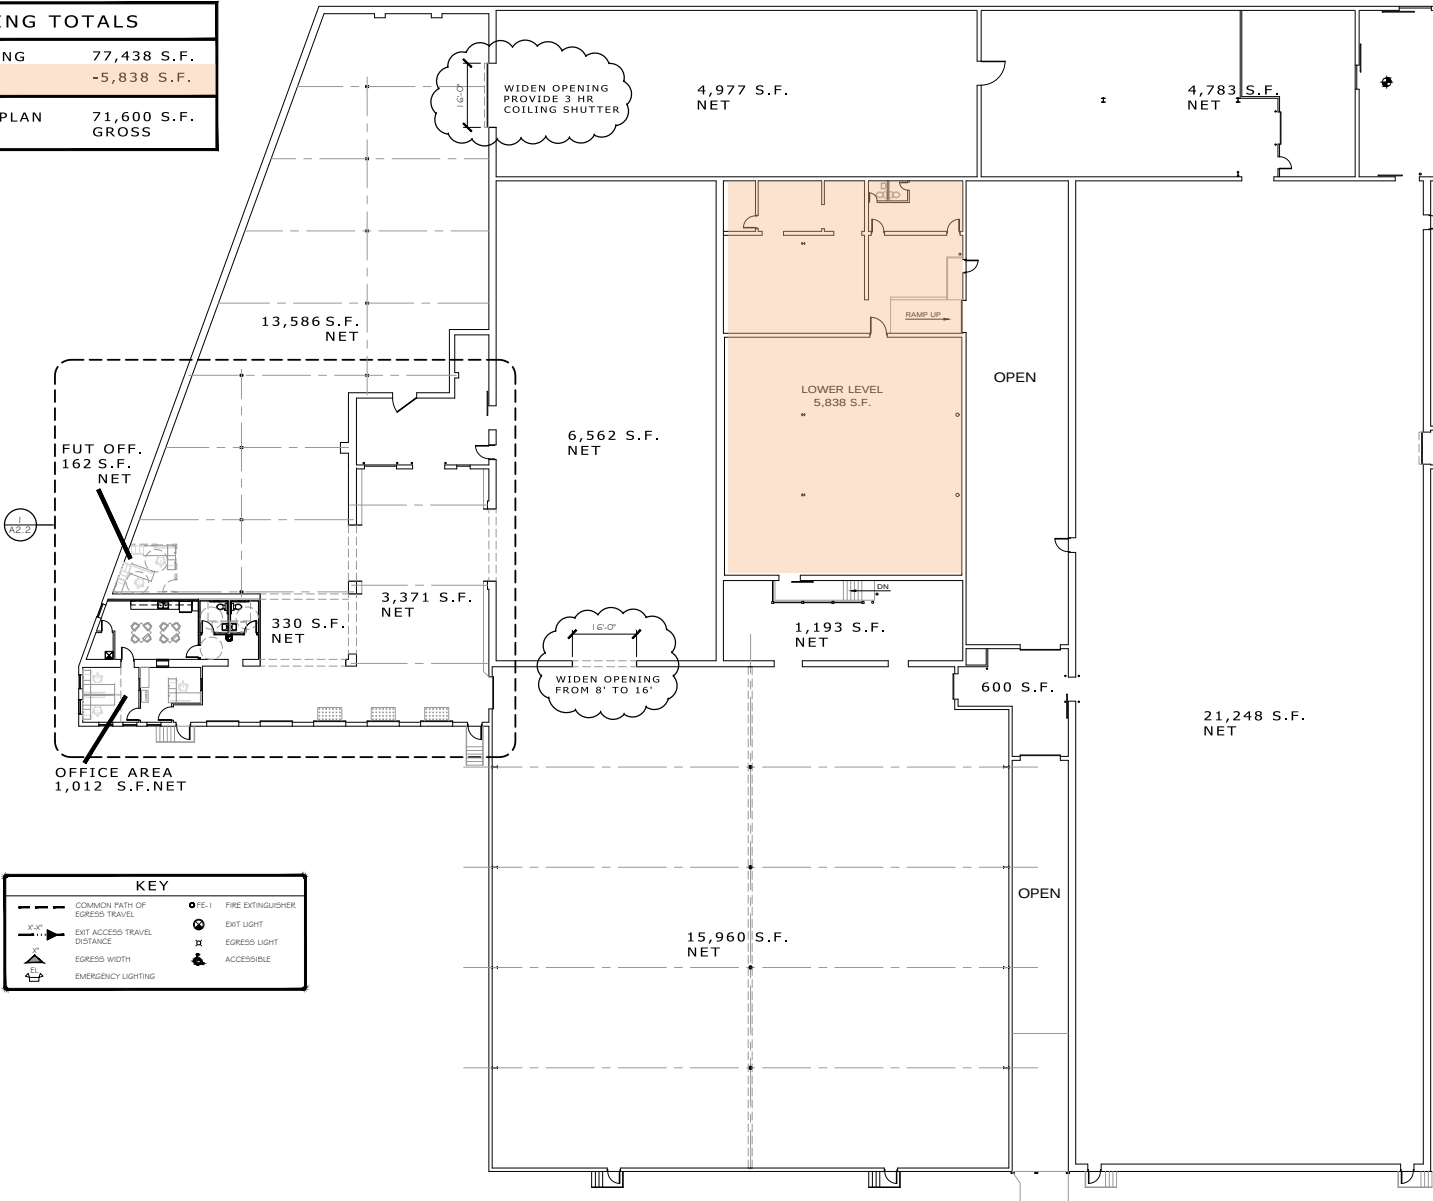

KEY	
--- COMMON PATH OF EGRESS TRAVEL	● FE-1 FIRE EXTINGUISHER
X-11 EXIT ACCESS TRAVEL DISTANCE	⊙ EXIT LIGHT
X-12 EGRESS WIDTH	⊙ EGRESS LIGHT
⊙ EMERGENCY LIGHTING	♿ ACCESSIBLE

FIRST FLOOR PLAN
SCALE: 1/16" = 1'-0" 77,438 S.F.
WITHOUT LOWER LEVEL 71,600 S.F.

