



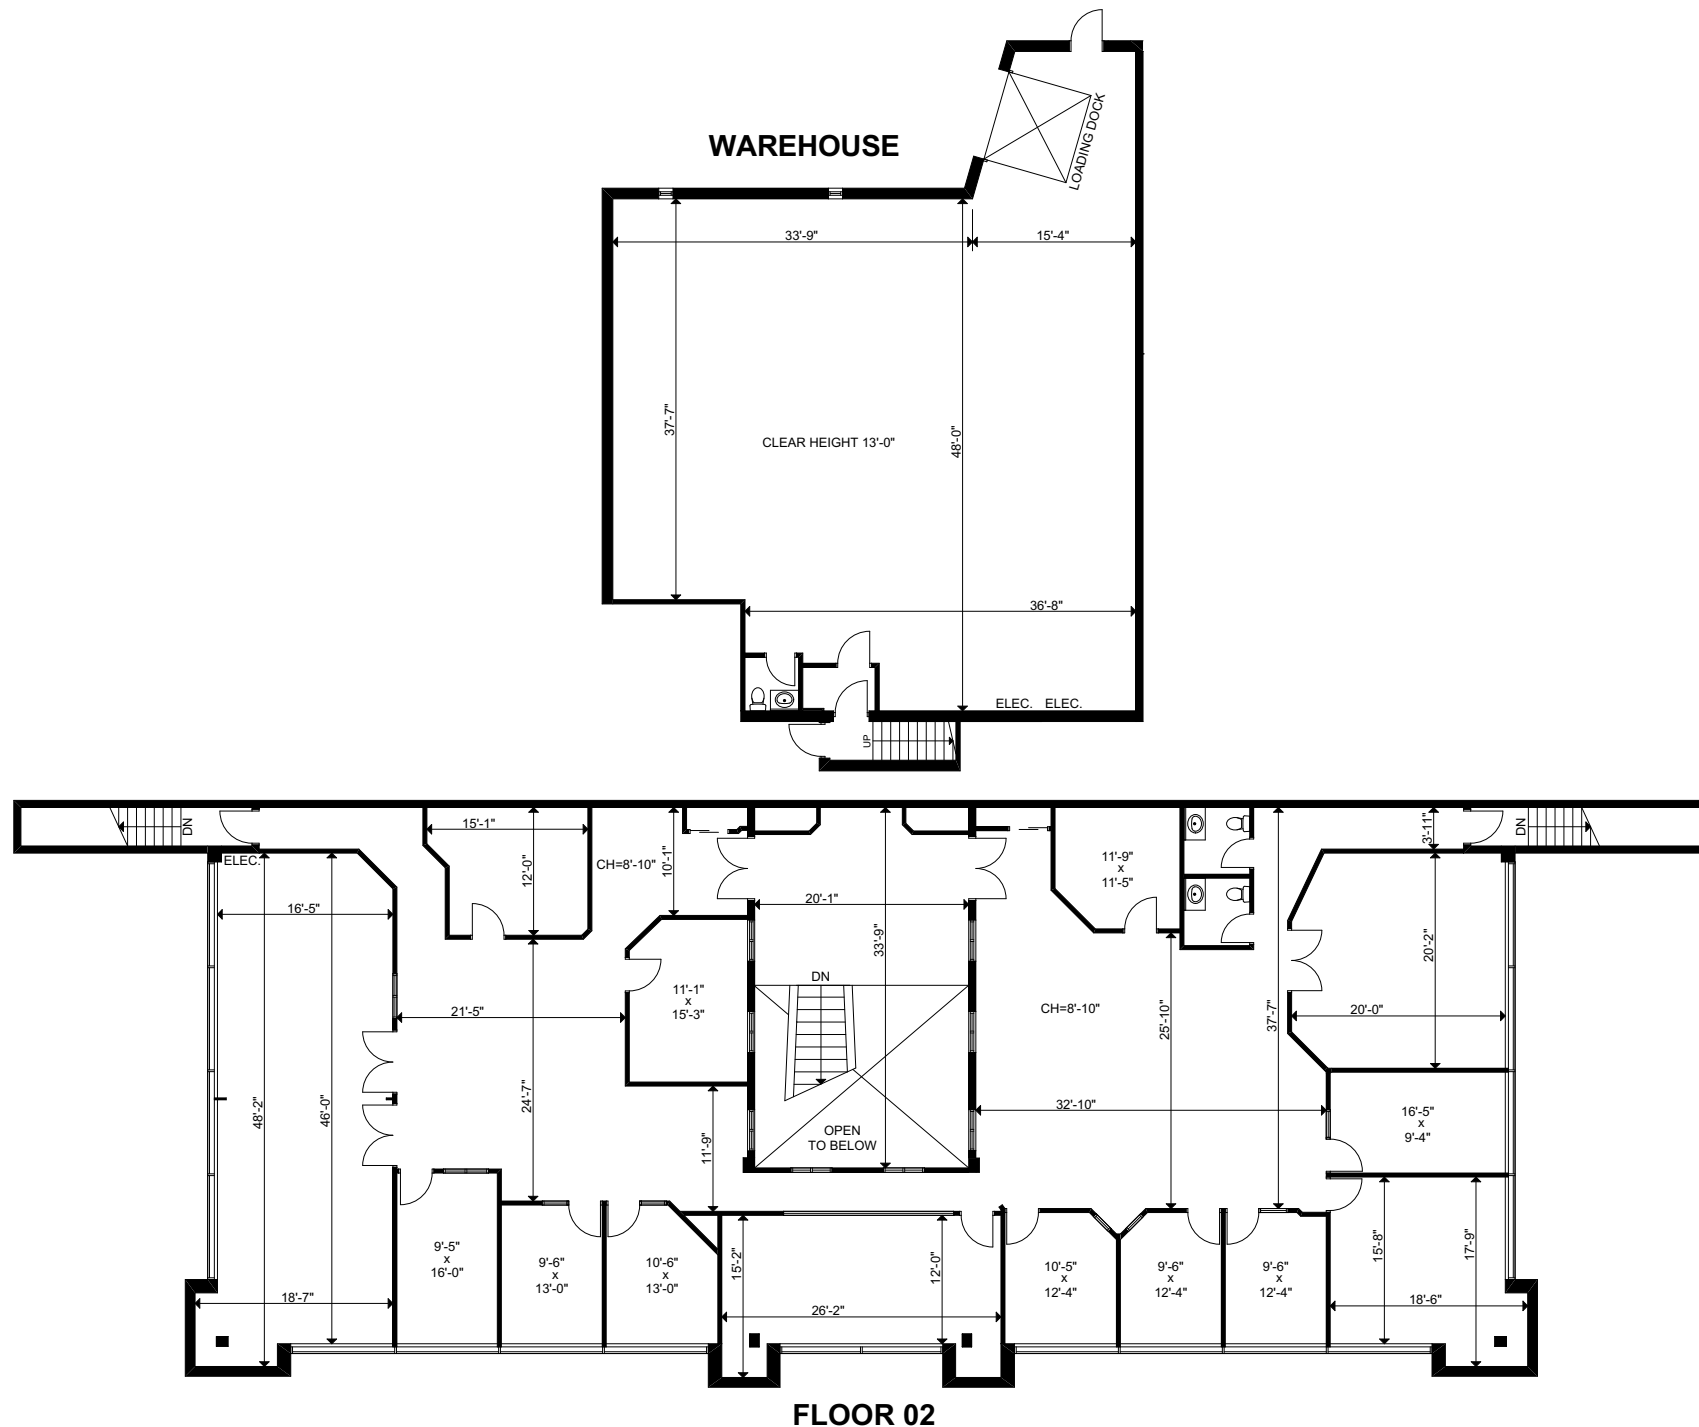

FLOOR 02

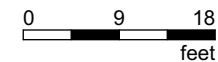

"Client"

Taylor Co. Ltd.

Version: V1	Prepared: 23/03/2023
	Measured: 17/03/2023

5353 John Lucas Drive
Burlington, Ontario

Warehouse and Floor 02

Warehouse Area:	2,439 sq ft
Floor 02 Area:	5,877 sq ft
Total Usable Area:	8,316 sq ft



This work product has been prepared by Extreme Measures Inc. pursuant to a contract with the Client for the sole benefit of and use by the Client. No third party may rely on this work product without the receipt of a reliance letter from Extreme Measures Inc.