


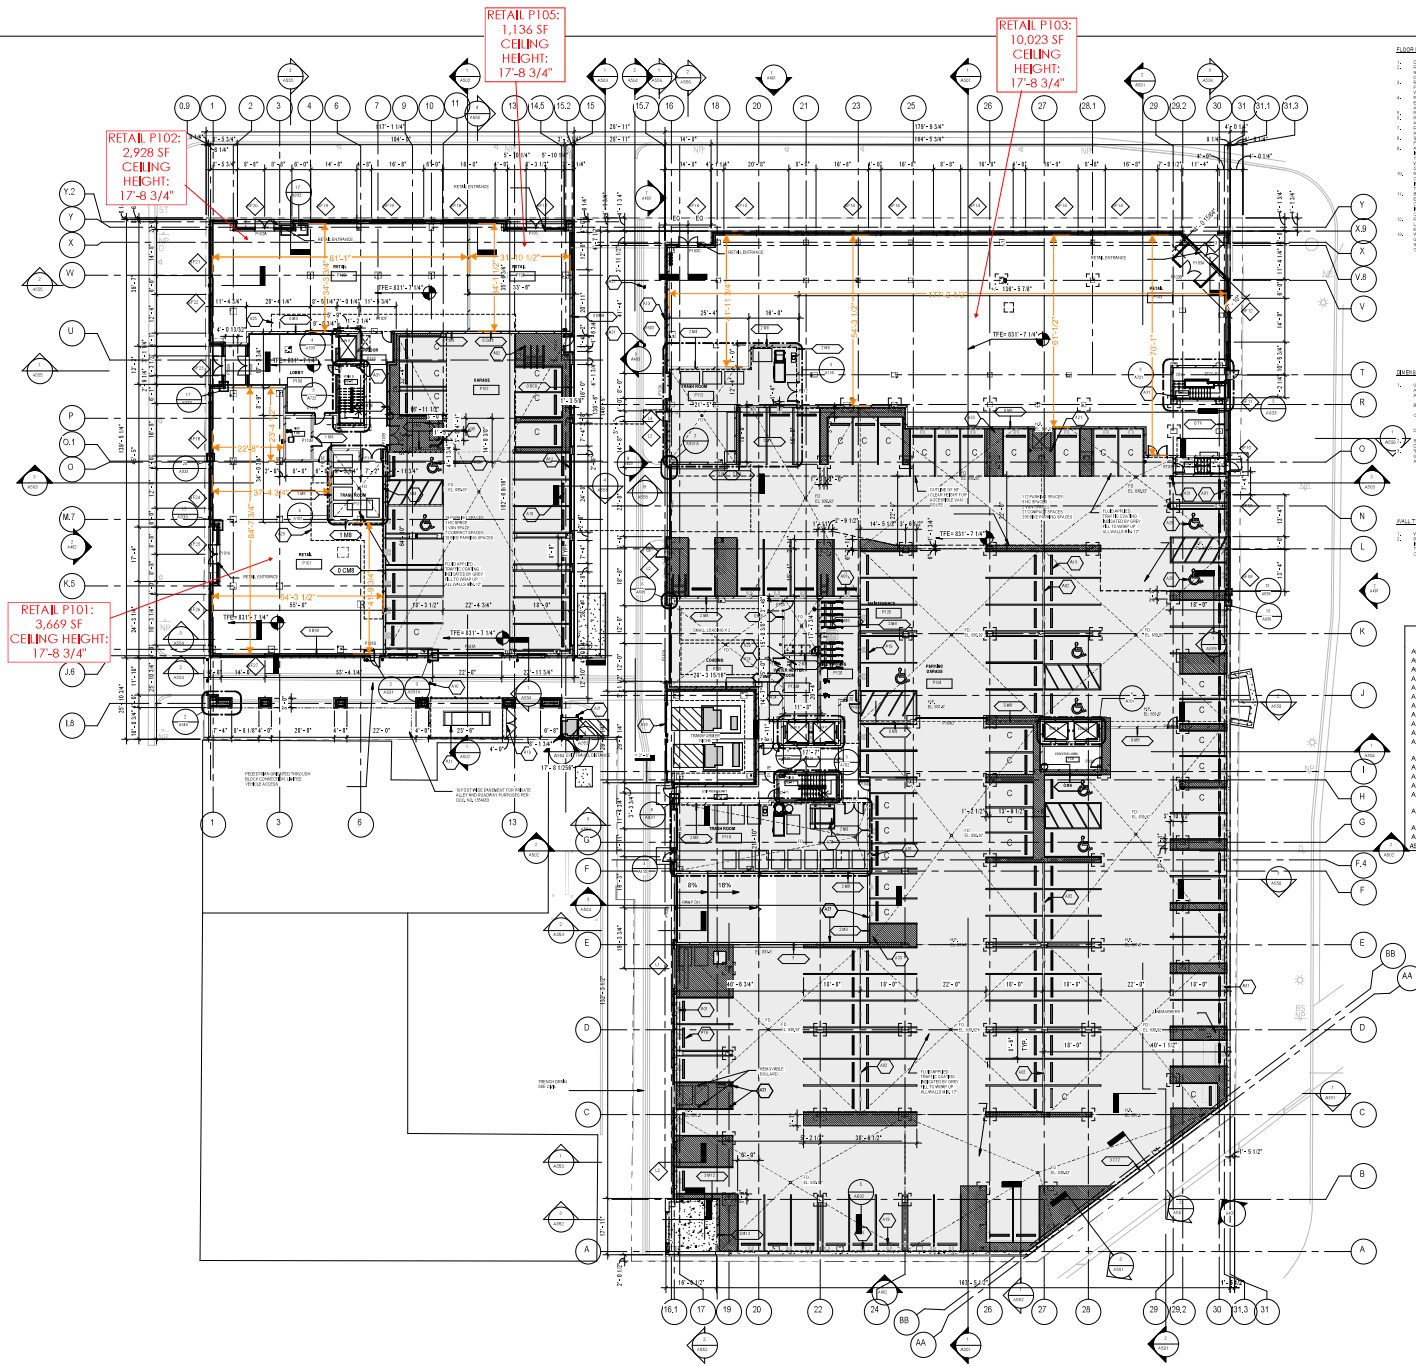

GENERAL NOTES

1. CONSULT ARCHITECT FOR ALL NOTES.
2. ALL WORK SHALL BE IN ACCORDANCE WITH THE LATEST EDITIONS OF THE BUILDING CODES AND ALL APPLICABLE SPECIFICATIONS.
3. ALL MATERIALS AND METHODS OF CONSTRUCTION SHALL BE APPROVED BY THE ARCHITECT PRIOR TO INSTALLATION.

REVISIONS

NO.	DATE	DESCRIPTION
1	07/20/2022	ISSUED FOR PERMIT

ARCHITECTURAL KEYNOTES





















B K V
GROUP

Architect
Interior Design
Landscape
Architect

200 South LaSalle Street
The Recovery
Suite 700
Chicago, IL
60604
312.779.0400
www.bkvgroup.com

CivilSite
GROUP

**Dinkytown
McDonald's
Redevelopment**

ISSUE #	DATE	DESCRIPTION
1	07/20/2022	SCHEMATIC DESIGN
2	07/20/2022	ISSUED FOR DESIGN
3	07/20/2022	ISSUED FOR PERMIT

CERTIFICATION

SHEET TITLE

LEVEL P1 & NORTH RETAIL - OVERALL FLOOR PLAN

SHEET NUMBER

A099

© 2021 B K V Group