


Jacob Schoeneck P:\2021_PROMO\Miracle Mile\Overall Floor plan update Thursday, September 16, 2021 1:04:42 PM

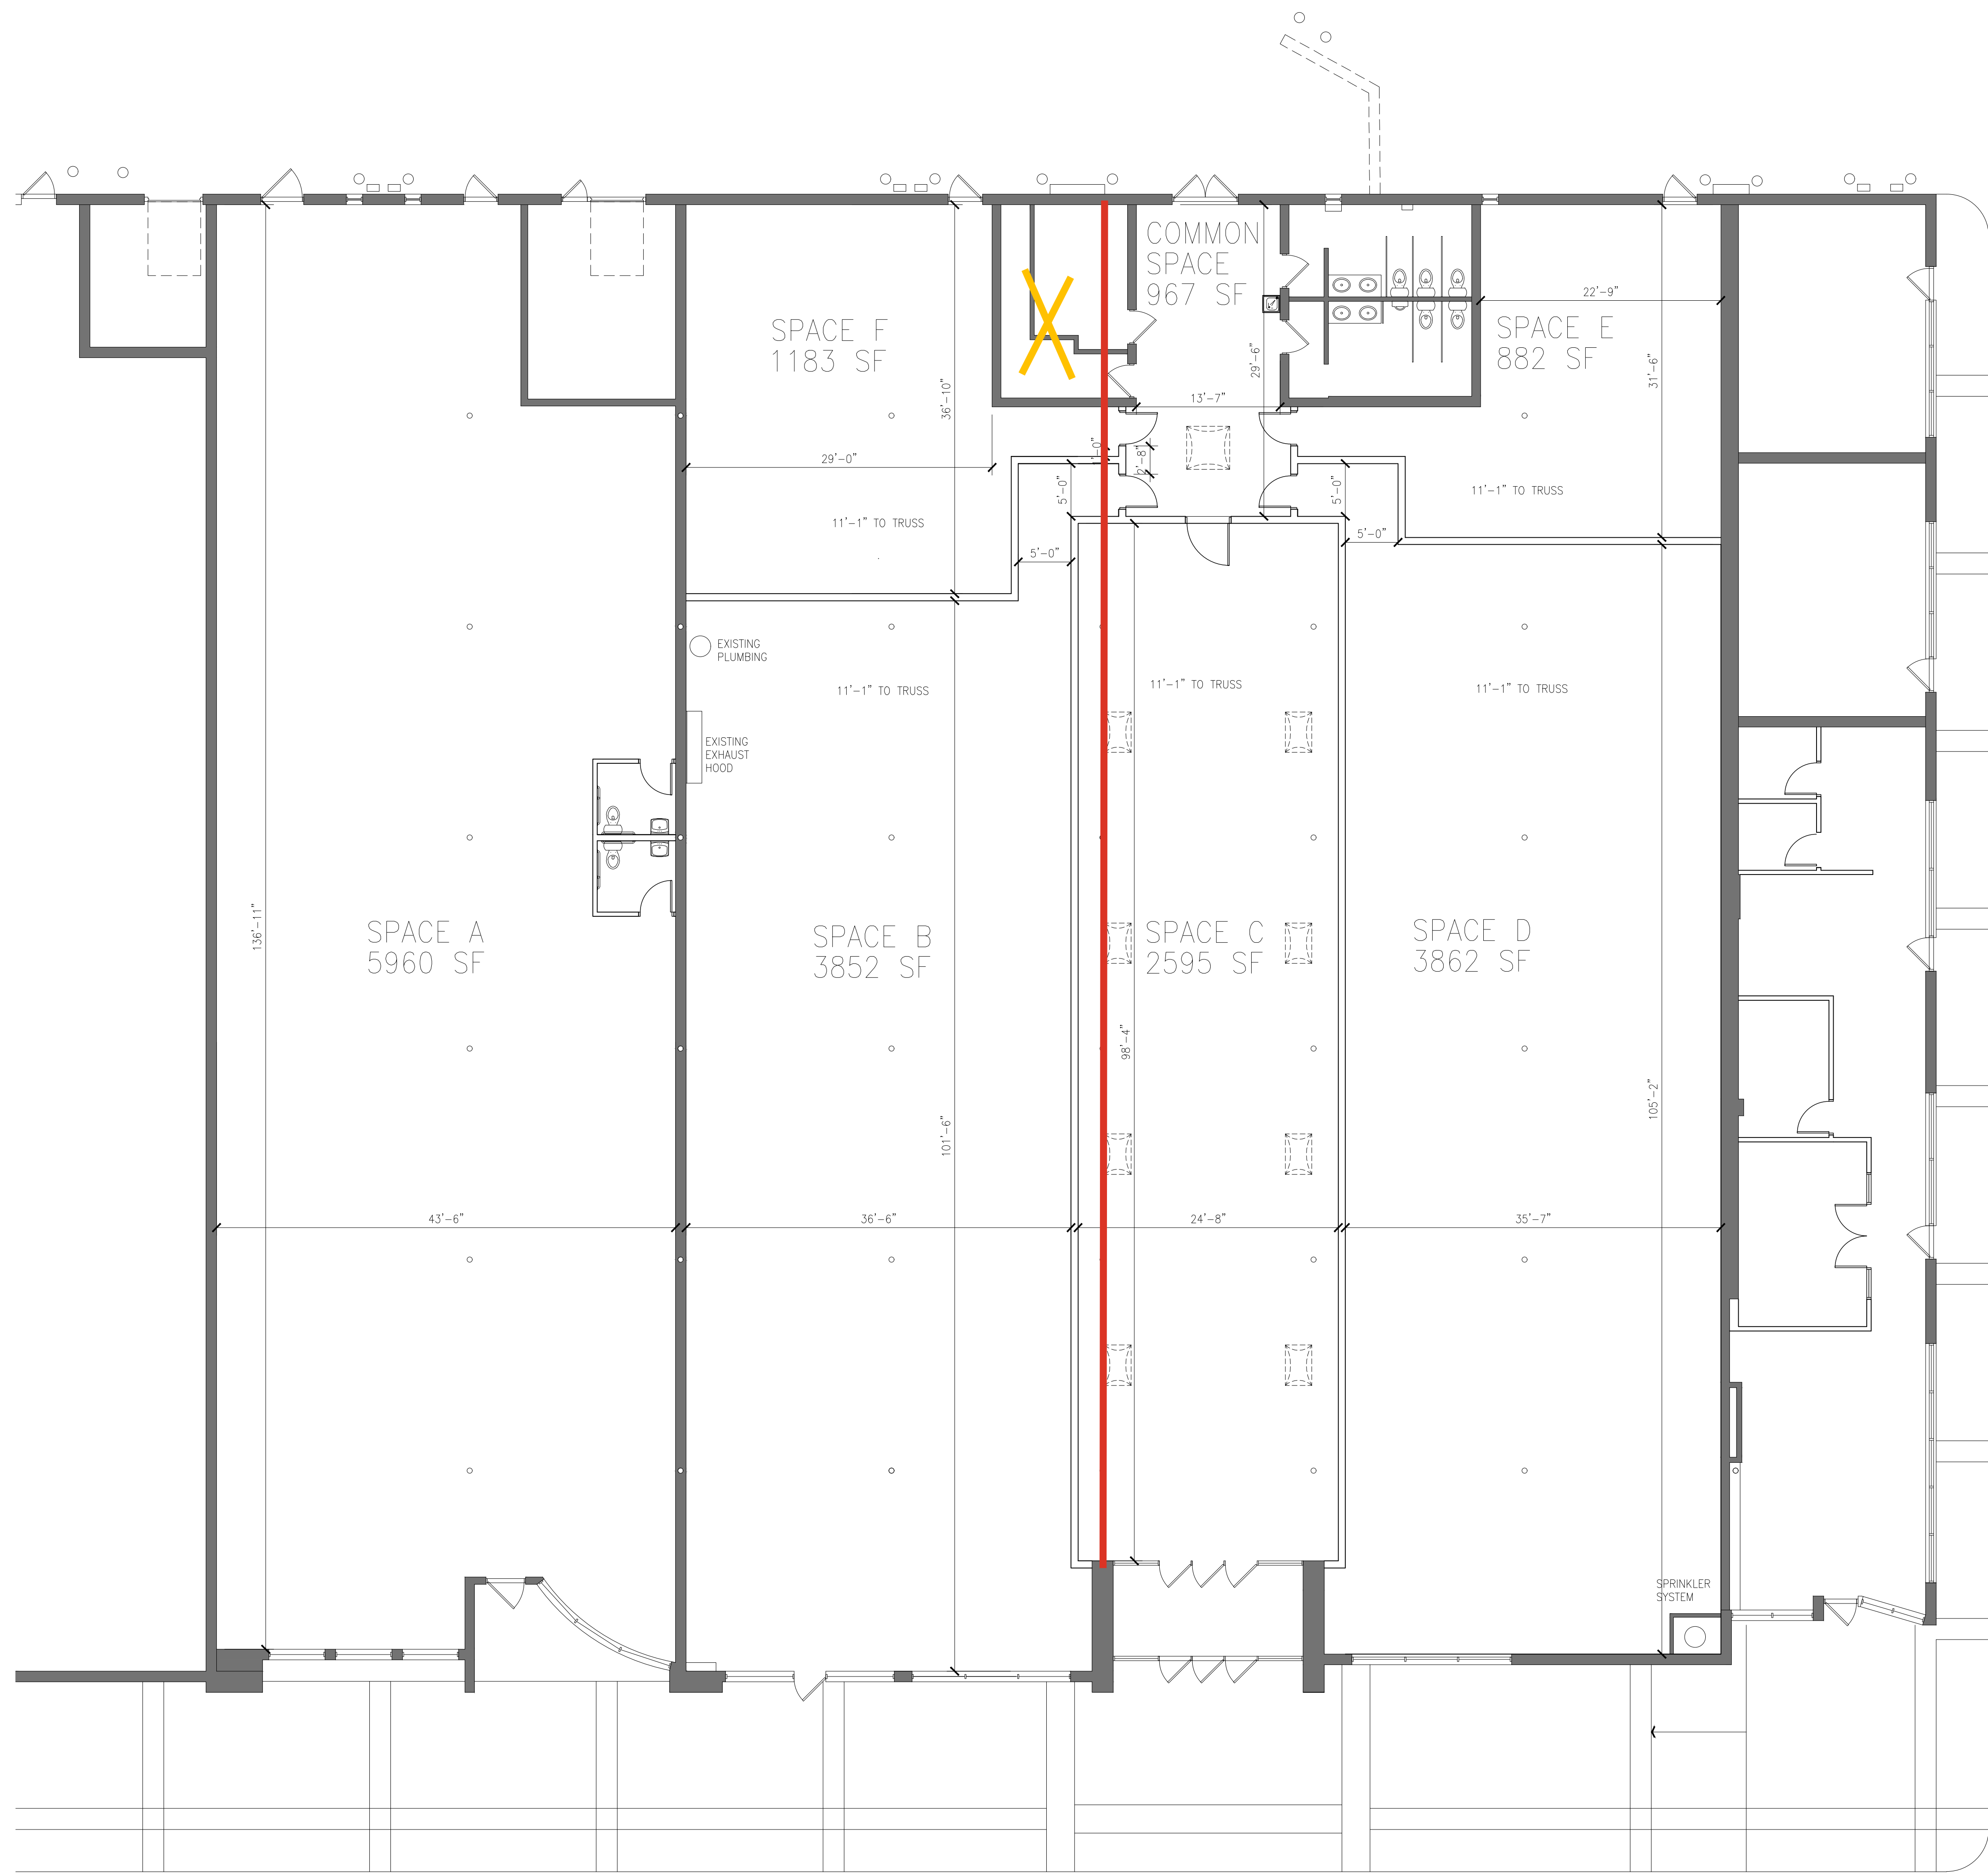

ALL DIMENSIONS SHOWN ARE FOR SCHEMATIC DESIGN PURPOSES. EXACT MEASUREMENTS FOR ALL FUTURE DESIGN/CONSTRUCTION ACTIVITIES MUST BE CONFIRMED ON SITE BY THE CONSULTANT/CONTRACTOR PERFORMING THE WORK

CRW

architecture
+ design group

211 eleventh avenue nw
rochester, mn 55901
p. 507.206.6201
f. 507.206.4621
www.crwarchitecture.com

MIRACLE MILE TENANT FIT-OUT

ROCHESTER, MINNESOTA

PROJECT NUMBER	PROMO
DATE	9-16-2021
DRAWN BY	JS
CHECKED BY	TTM
ISSUE / REVISION HISTORY	

TENANT FLOOR PLAN

SHEET NUMBER

A1

OF ### SHEETS

