

FOR SALE
1704-1710 WESTERN AVE
LAS VEGAS, NV 89102
\$3,650,000



APRIL MCLEMORE LIC. # S.190487
APRIL.MCLEMORE@FREC.NV.COM
(702) 672-4127
FIRST COMMERCIAL

COLLEEN MCDONALD LIC.# S.172426
COLLEEN.MCDONALD@FREC.NV.COM
(702) 348-8837
FIRST REAL ESTATE COMPANIES



PROPERTY OVERVIEW:

- **BUILDING SIZE: ±13,750 SF GROSS BUILDING SIZE.**
- **LOT SIZE: 0.95 ACRES**
- **YEAR BUILT BETWEEN 1964**
- **ZONING: COMMERCIAL/INDUSTRIAL (ZONED 32003C2170F), ALLOWING FOR FOOD PROCESSING, AUTOMOTIVE, WHOLESALE, AND LIGHT MANUFACTURING.**
- **OCCUPANCY STATUS: CURRENTLY FULLY OCCUPIED BY ESTABLISHED TENANTS**

HIGHLIGHTS:

- **SITUATED IN THE HIGHLAND COMPLEX AREA, ONE MINUTE FROM THE I-15 FREEWAY AND FIVE MINUTES FROM THE LAS VEGAS ARTS DISTRICT.**
- **FEATURES MULTIPLE UNITS, EACH EQUIPPED WITH PRIVATE RESTROOMS AND INDIVIDUAL GRADE-LEVEL ROLL-UP DOORS.**
- **OFFERS IMMEDIATE PROXIMITY TO MAJOR THOROUGHFARES INCLUDING OAKLEY BOULEVARD, CHARLESTON BOULEVARD, AND THE LAS VEGAS STRIP.**
- **IDEAL FOR AN INVESTOR SEEKING STABLE CASH FLOW FROM LONG-TERM TENANTS OR AN OWNER-USER LOOKING FOR PHASED OCCUPANCY TO OFFSET MORTGAGE COSTS.**
- **POSITIONED WITHIN THE RAPIDLY DEVELOPING WESTERN AVENUE CORRIDOR, PROVIDING UNMATCHED VISIBILITY FOR LOCAL AND REGIONAL LOGISTICS.**

frecnv.com




First Commercial



First Real Estate
Positively Vegas

THE INFORMATION PROVIDED HEREIN HAS BEEN GATHERED FROM SOURCES DEEMED RELIABLE. HOWEVER, FIRST REAL ESTATE COMPANIES, LLC IS NOT RESPONSIBLE FOR ANY ERROR, OMISSION OR INACCURACY. 01/27/2026

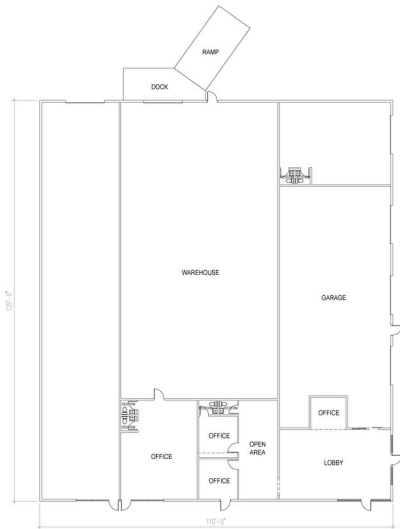

1 Main Structure As-Built Floor Plan
SCALE: 1/4" = 1'-0"



2 Accessory Structure As-Built Floor Plan
SCALE: 1/4" = 1'-0"

NO.	REVISION
1	AS-BUILT FLOOR PLAN

1704-1710 Western Ave.
Las Vegas, NV 89102

AS-BUILT FLOOR PLAN

DATE: 01/27/2024
DRAWN BY:
SCALE: AS NOTED
SHEET

A1.00


NO.	REVISION

1704-1710 Western Ave. Las Vegas, NV 89102

AS-BUILT FLOOR PLAN AREA BREAKDOWN

DATE: 01/26/2026 DRAWN BY: [Signature] CHECKED BY: [Signature]
--

SHEET A2.00

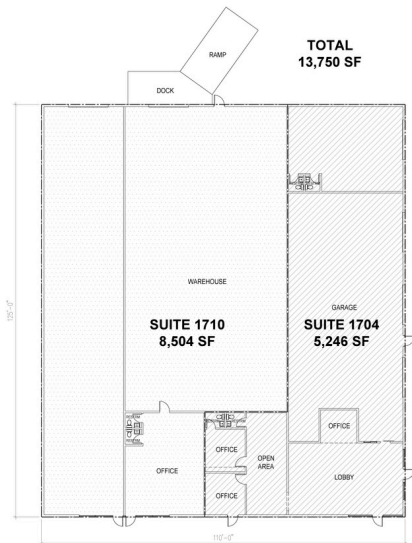

1704-1710 Western Ave. As-Built Floor Plan (Area Breakdown)



Accessory Structure As-Built Floor Plan

