



NEVINS STREET

BUTLER STREET

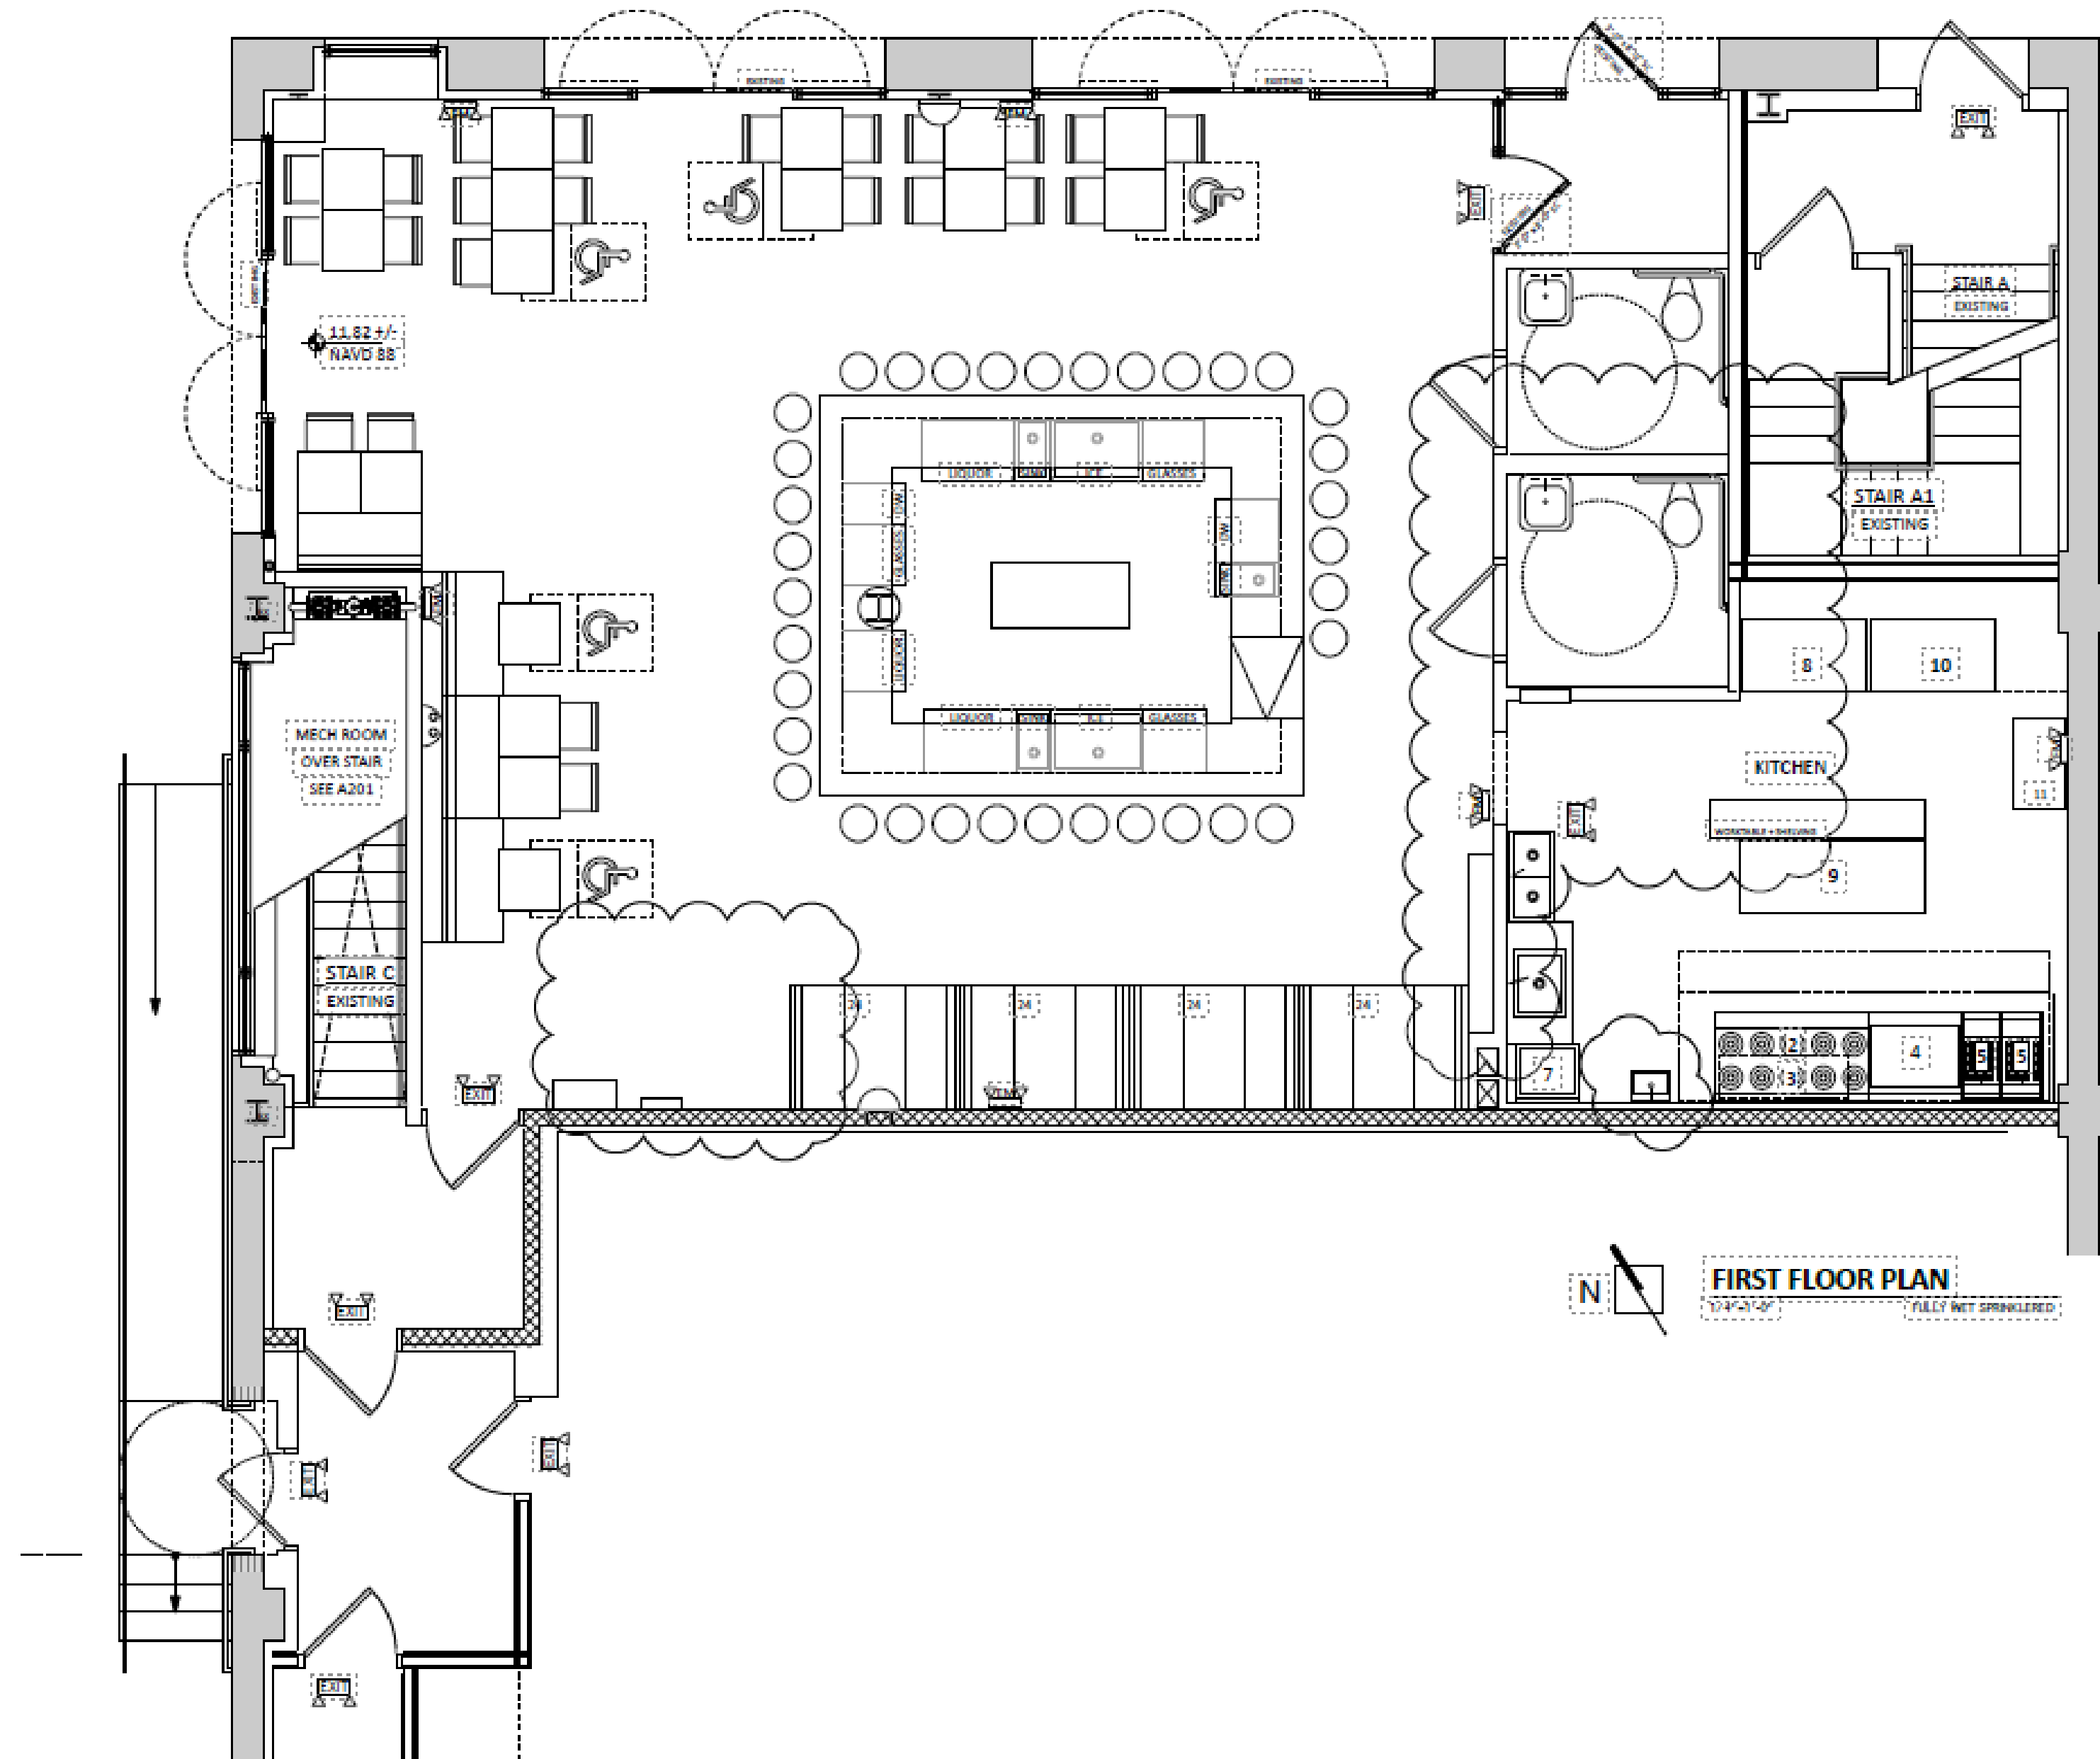

BUTLER STREET

NEVINS STREET

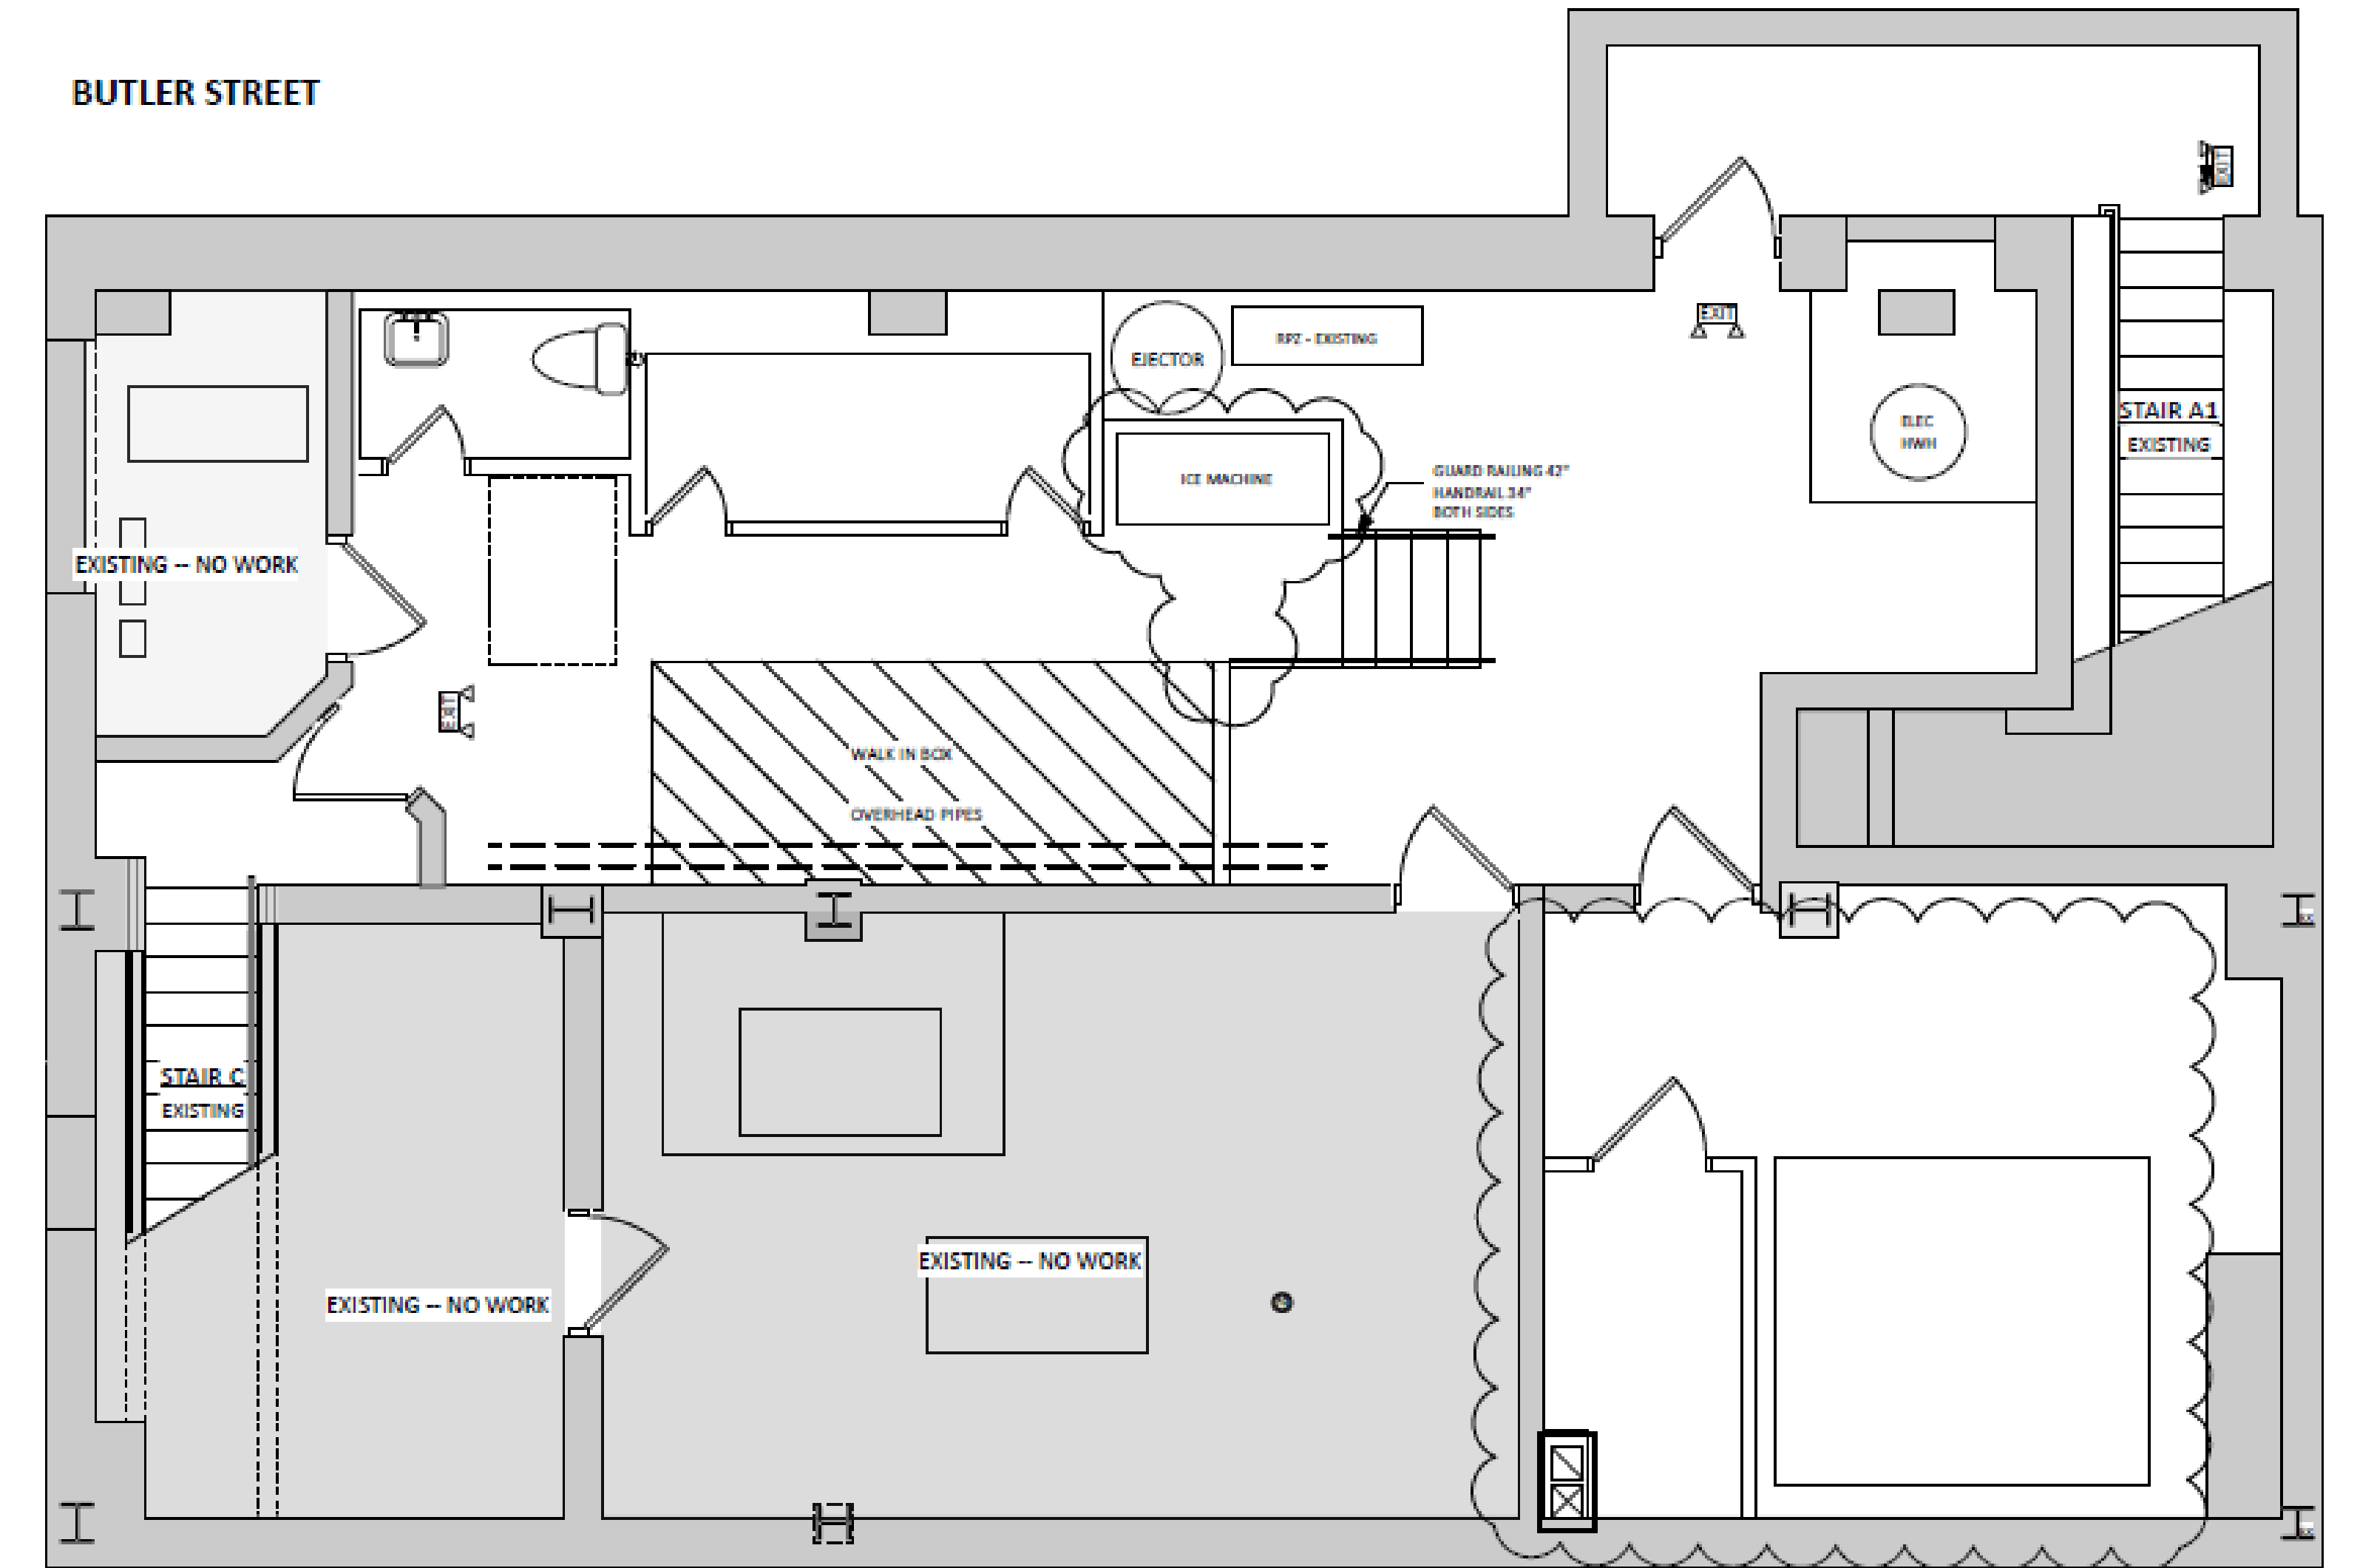

CELLAR PLAN
1/4"=1'-0"
FULLY WET SPRINKLERED

