STERLING POINTE

303 Perimeter Center North

SUITE 500
8,666 RSF

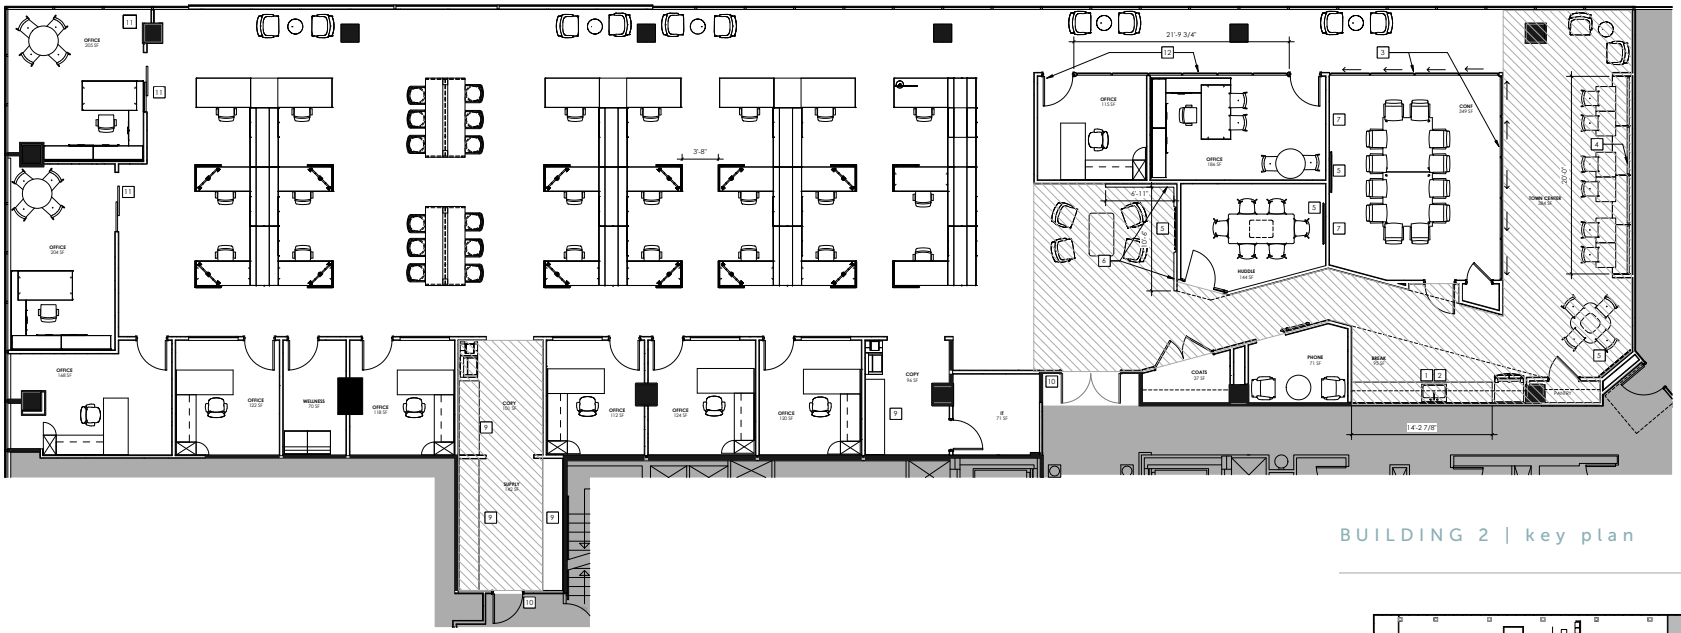

BUILDING 2 | key plan

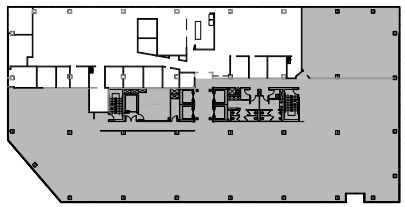

KEVIN DRIVER

+1 404.574.1082

kevin.driver@colliers.com

DEMING FISH

+1 404.877.9270

deming.fish@colliers.com

Colliers

Copyright © 2026 Colliers International.
Information herein has been obtained from sources deemed reliable, however its accuracy cannot be guaranteed. The user is required to conduct their own due diligence and verification.