


Valley Square Office Building

Golden Valley, MN

Suite 250

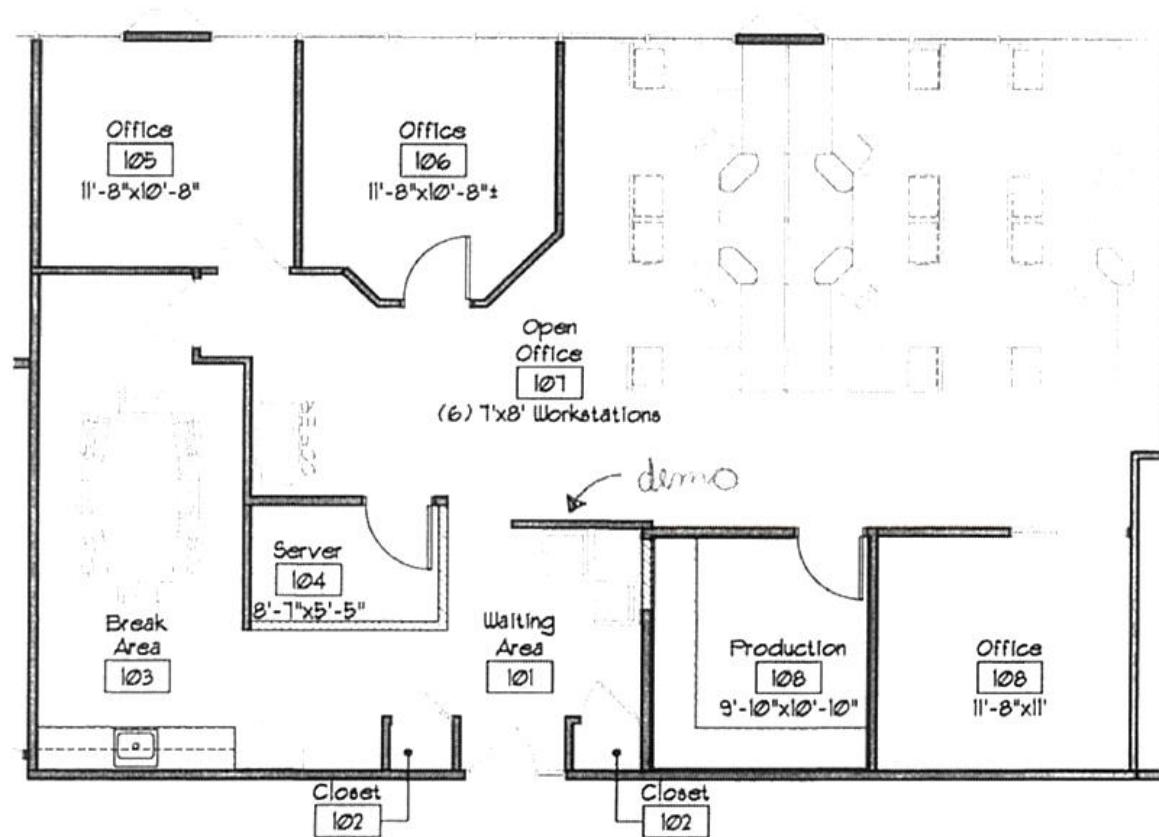

 Office – 2,056 RSF



Kevin O'Neill, SIOR

+1 952 897 7724

kevin.oneill@colliers.com