



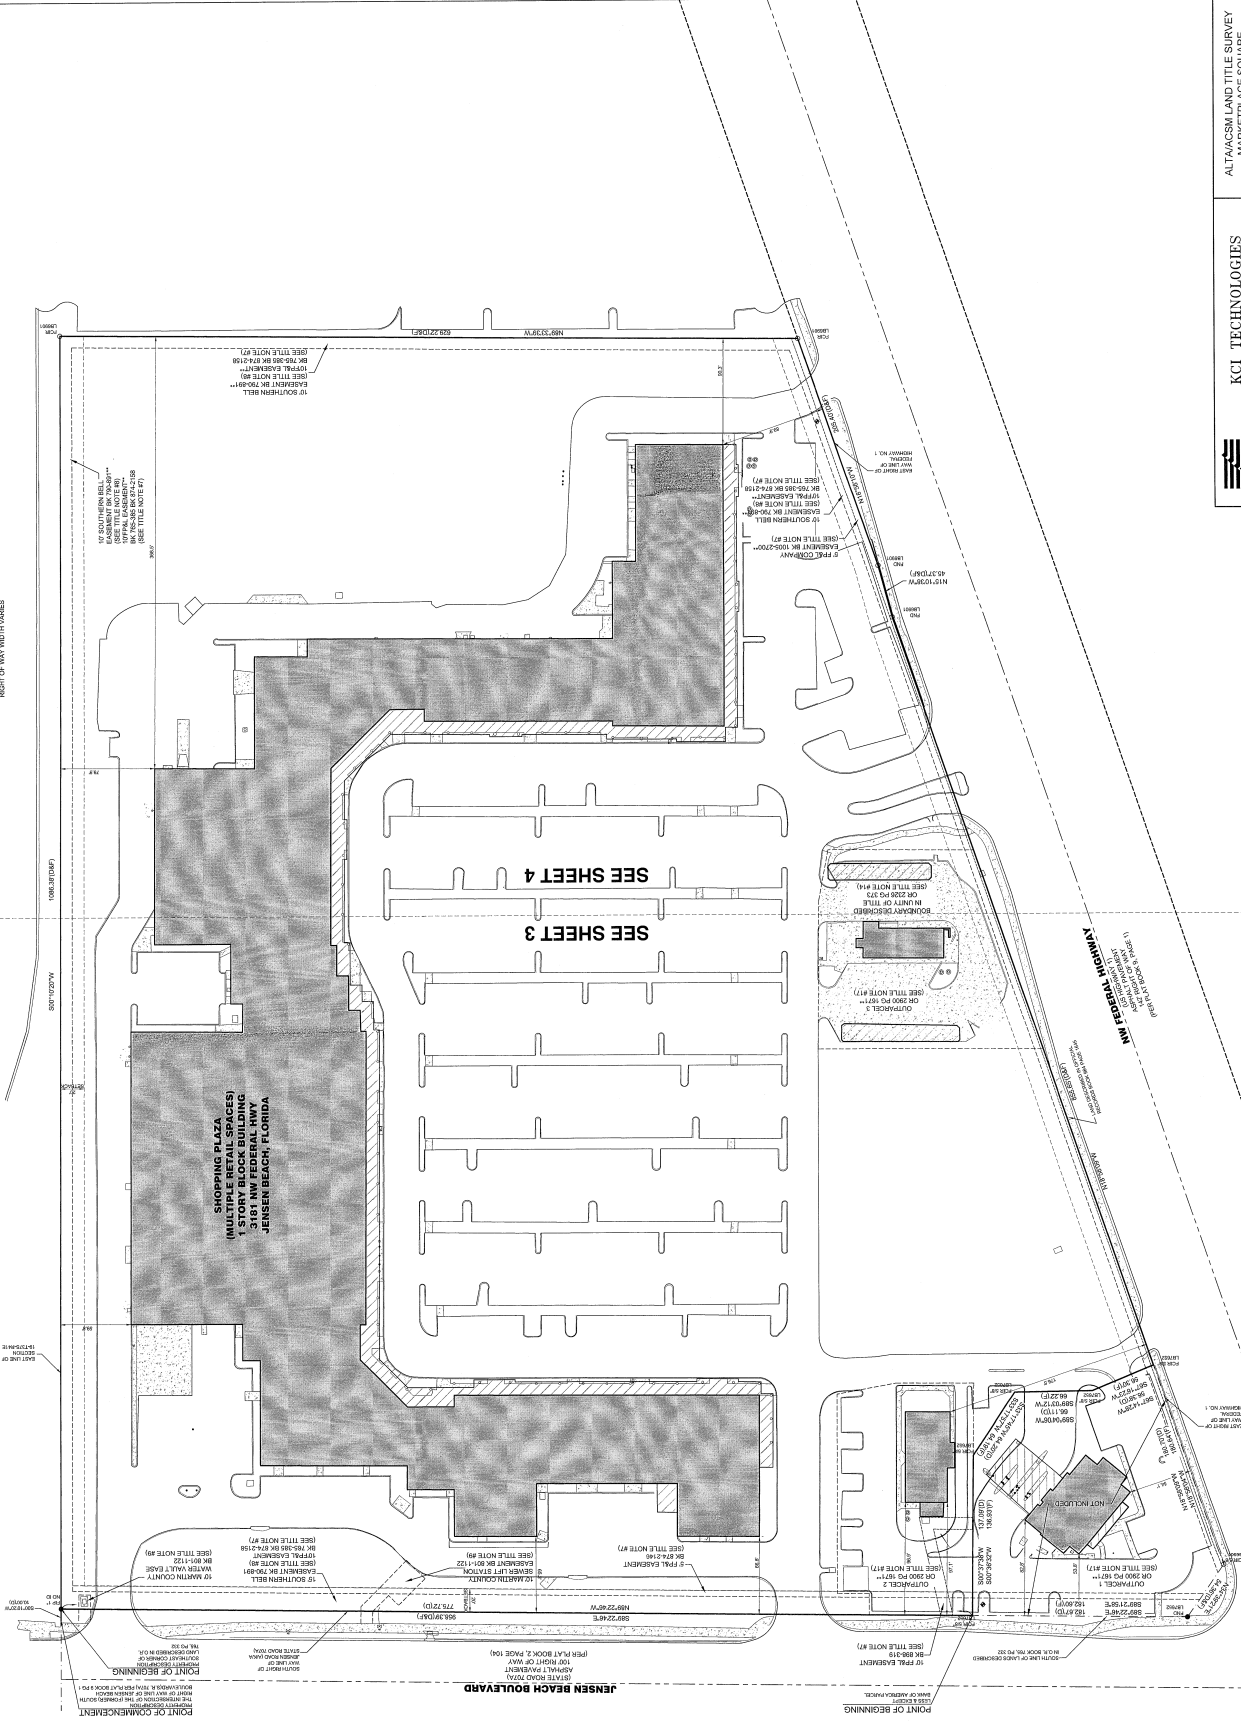

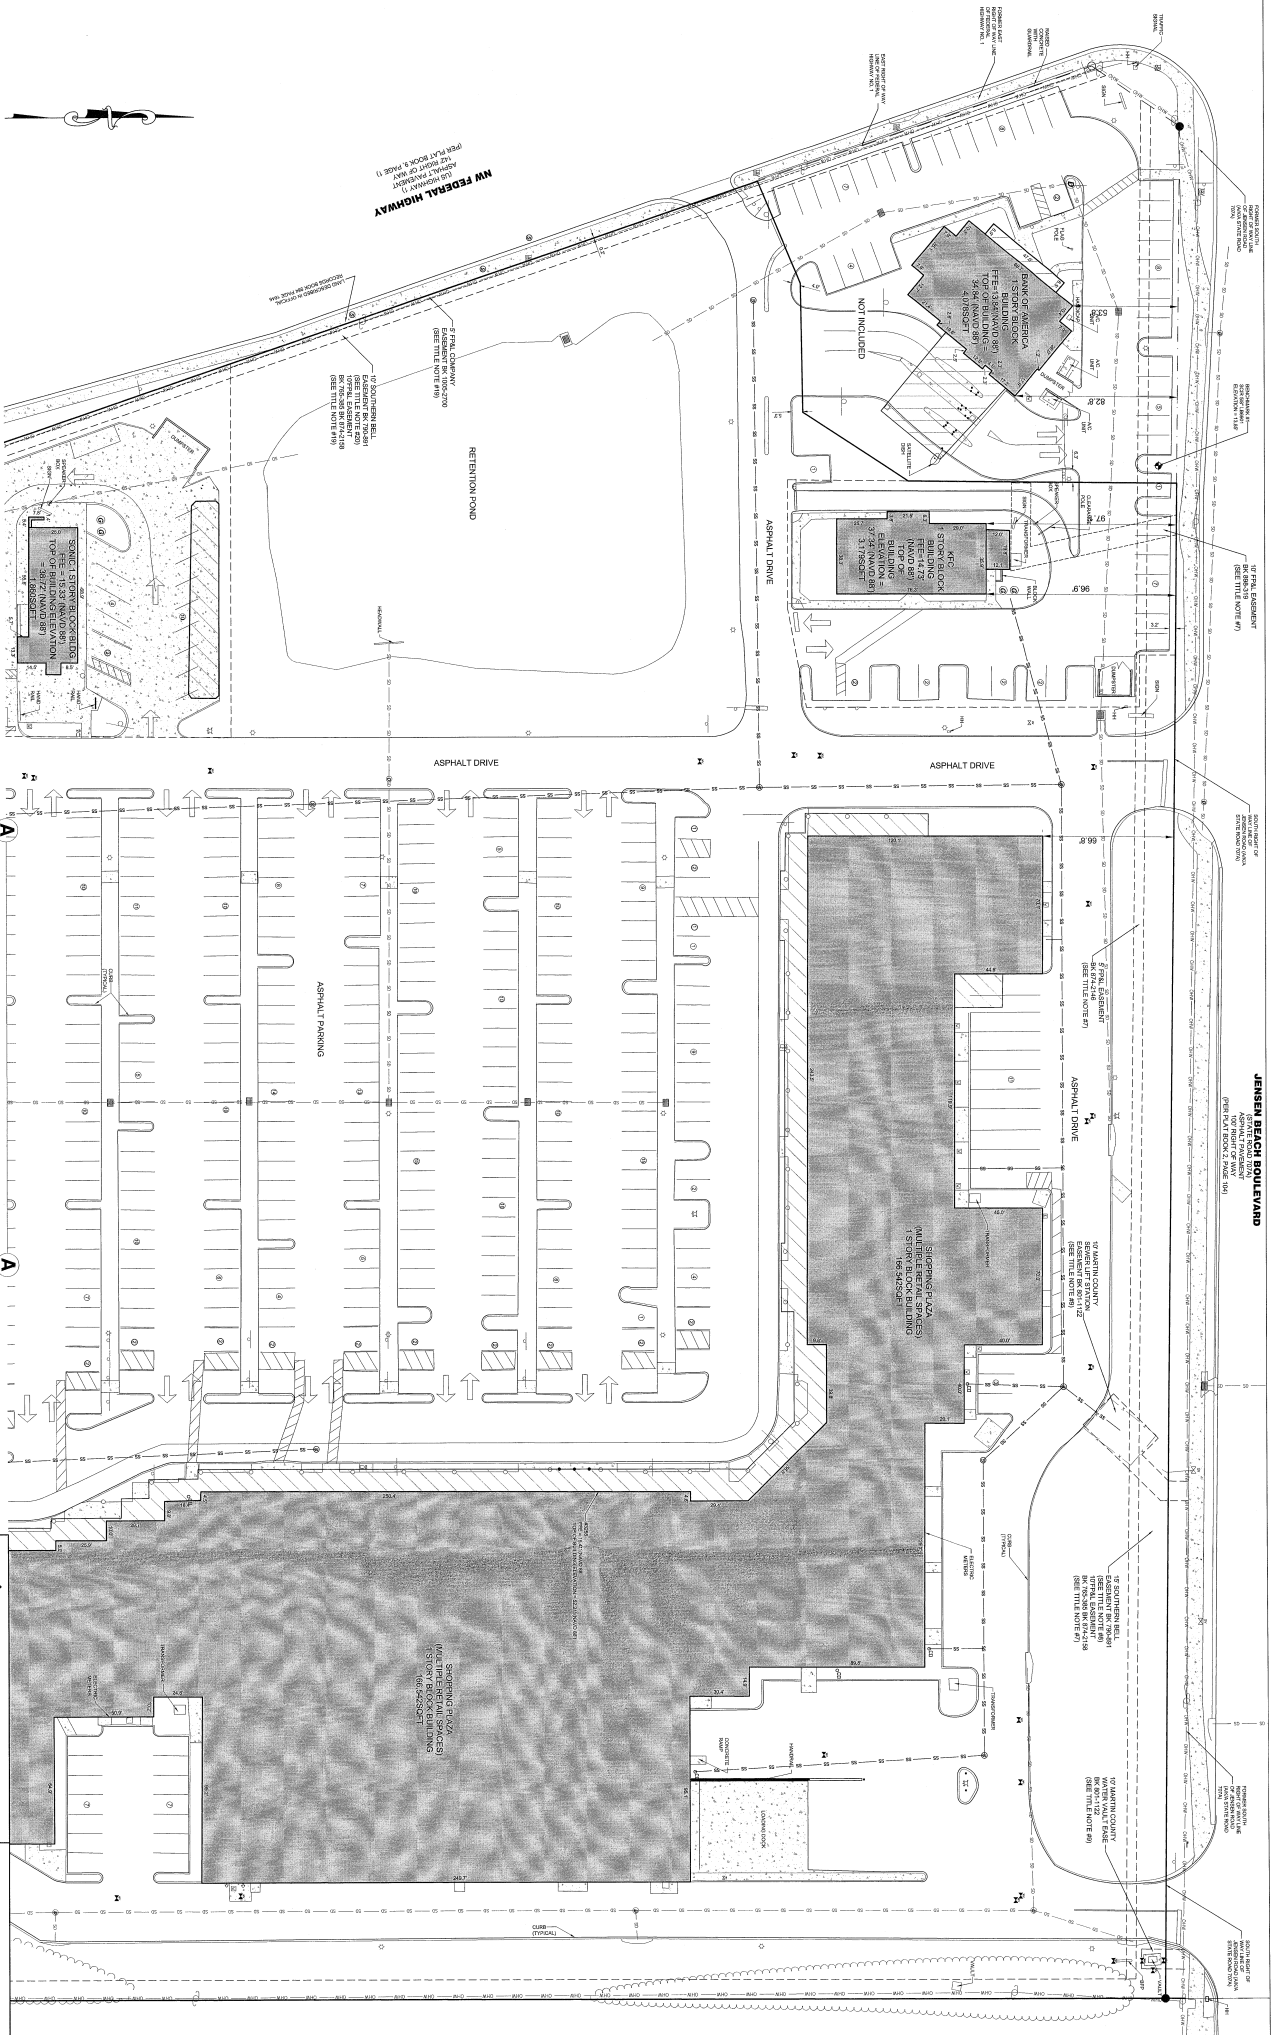

GRID NORTH
GRAPHIC SCALE

SEE SHEET 4

JENSEN BEACH BOULEVARD
(STATE ROAD 707A)



KCI TECHNOLOGIES
ENGINEERS, SURVEYORS AND PLANNERS
LICENSED BUSINESS 6001
10401 HIGHLAND MANOR DRIVE, SUITE 120
TAMPA, FL 33610
PHONE (813) 740-2300 * FAX (813) 740-0159

ALTA/ACSM LAND TITLE SURVEY
MARKETPLACE SQUARE
3181 NW FEDERAL HWY
JENSEN BEACH, FLORIDA

SEE SHEET 3

