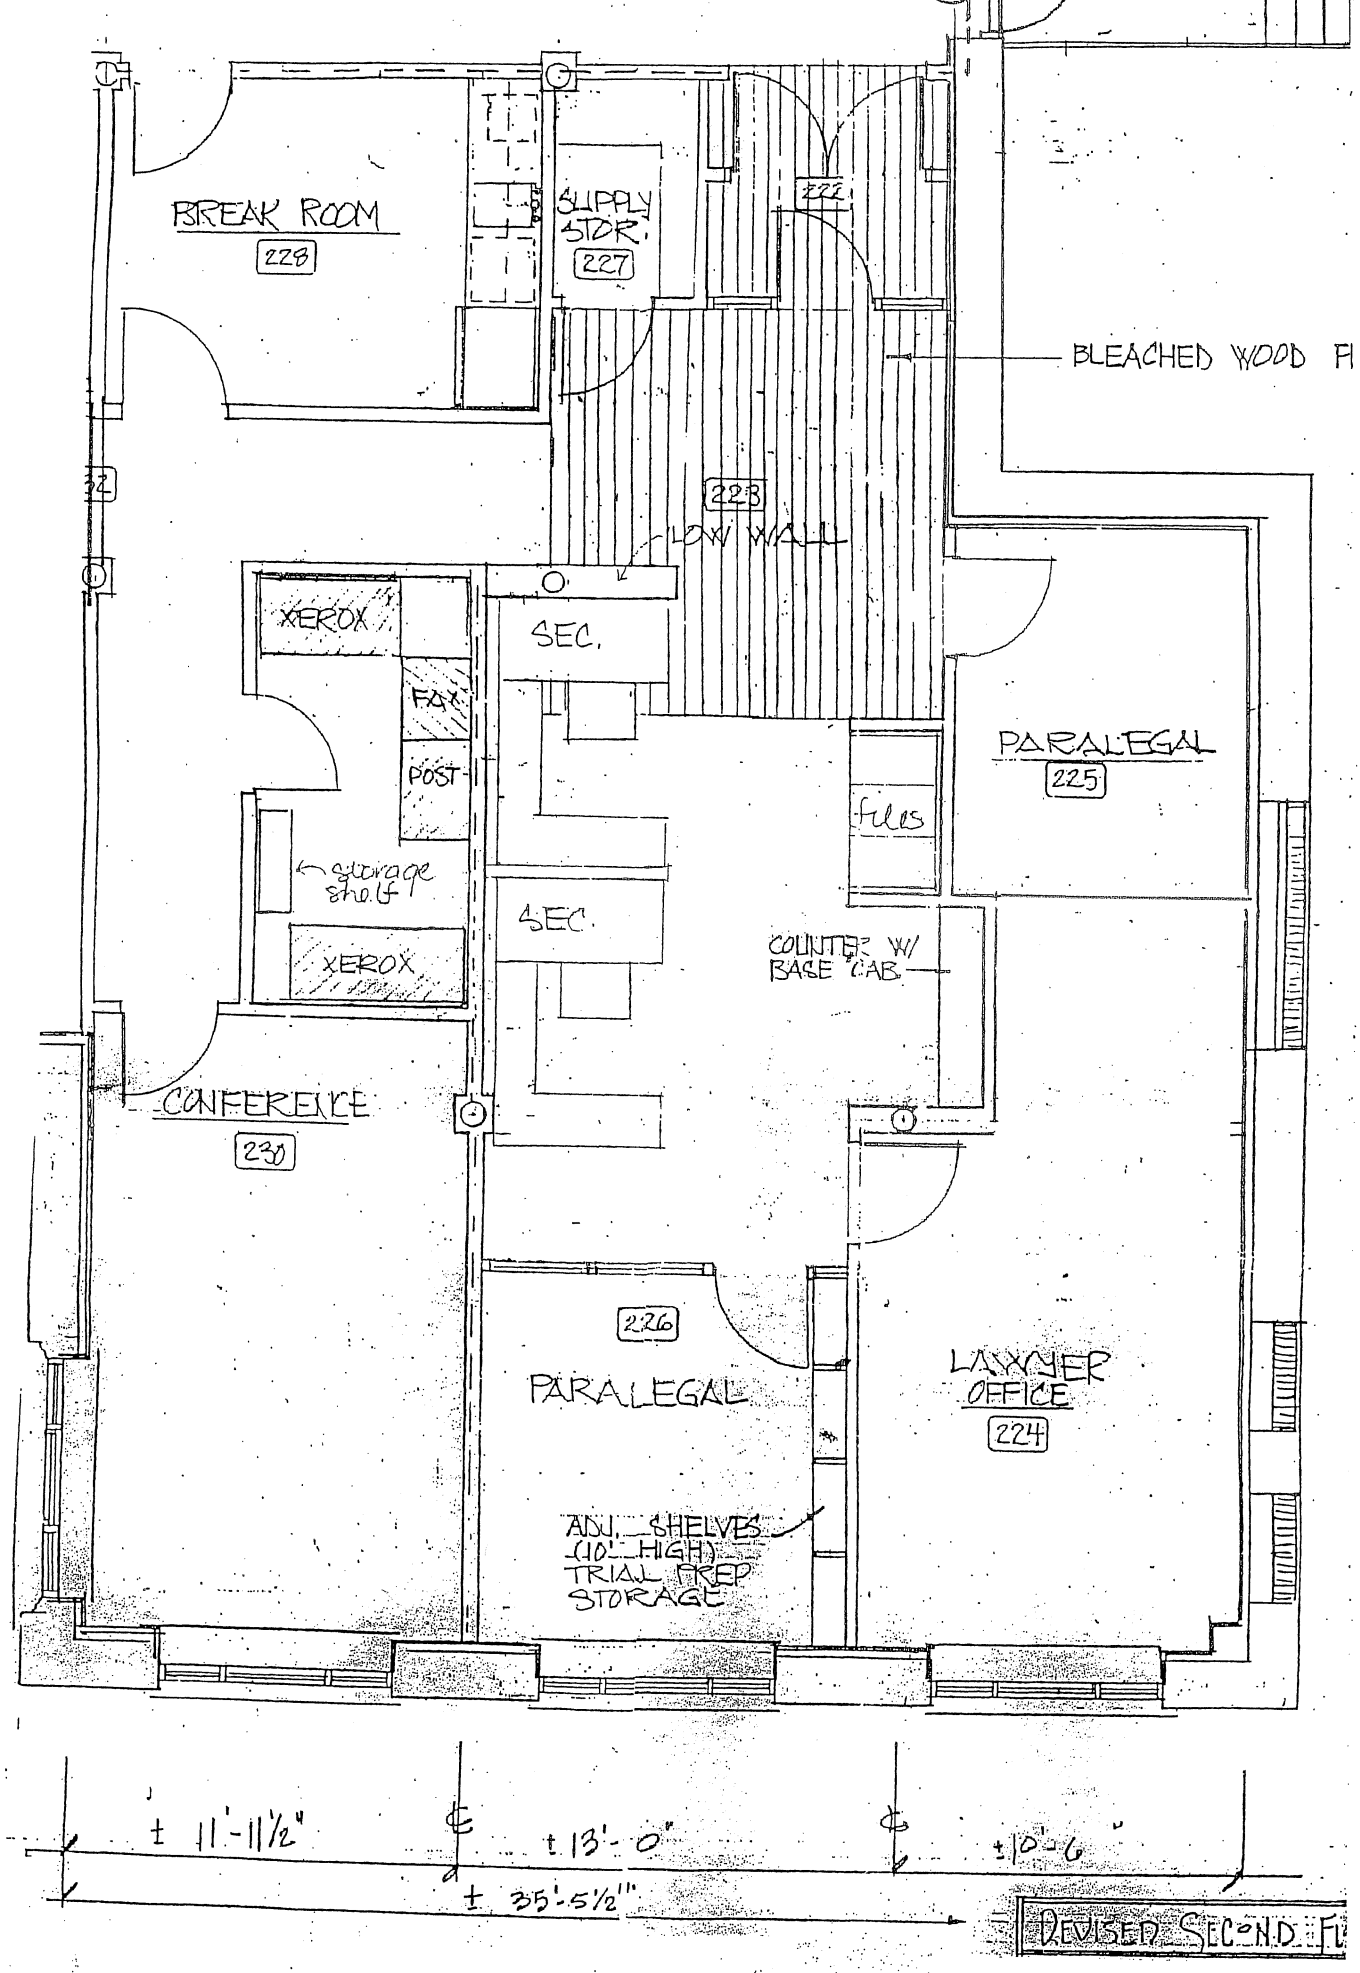

As Built Suite 201