


PARTRIDGE
ARCHITECTS INC

1617 JFK BOULEVARD, SUITE 900
PHILADELPHIA, PA 19103
215.567.3595P
215.557.7984F
www.partridgearch.com

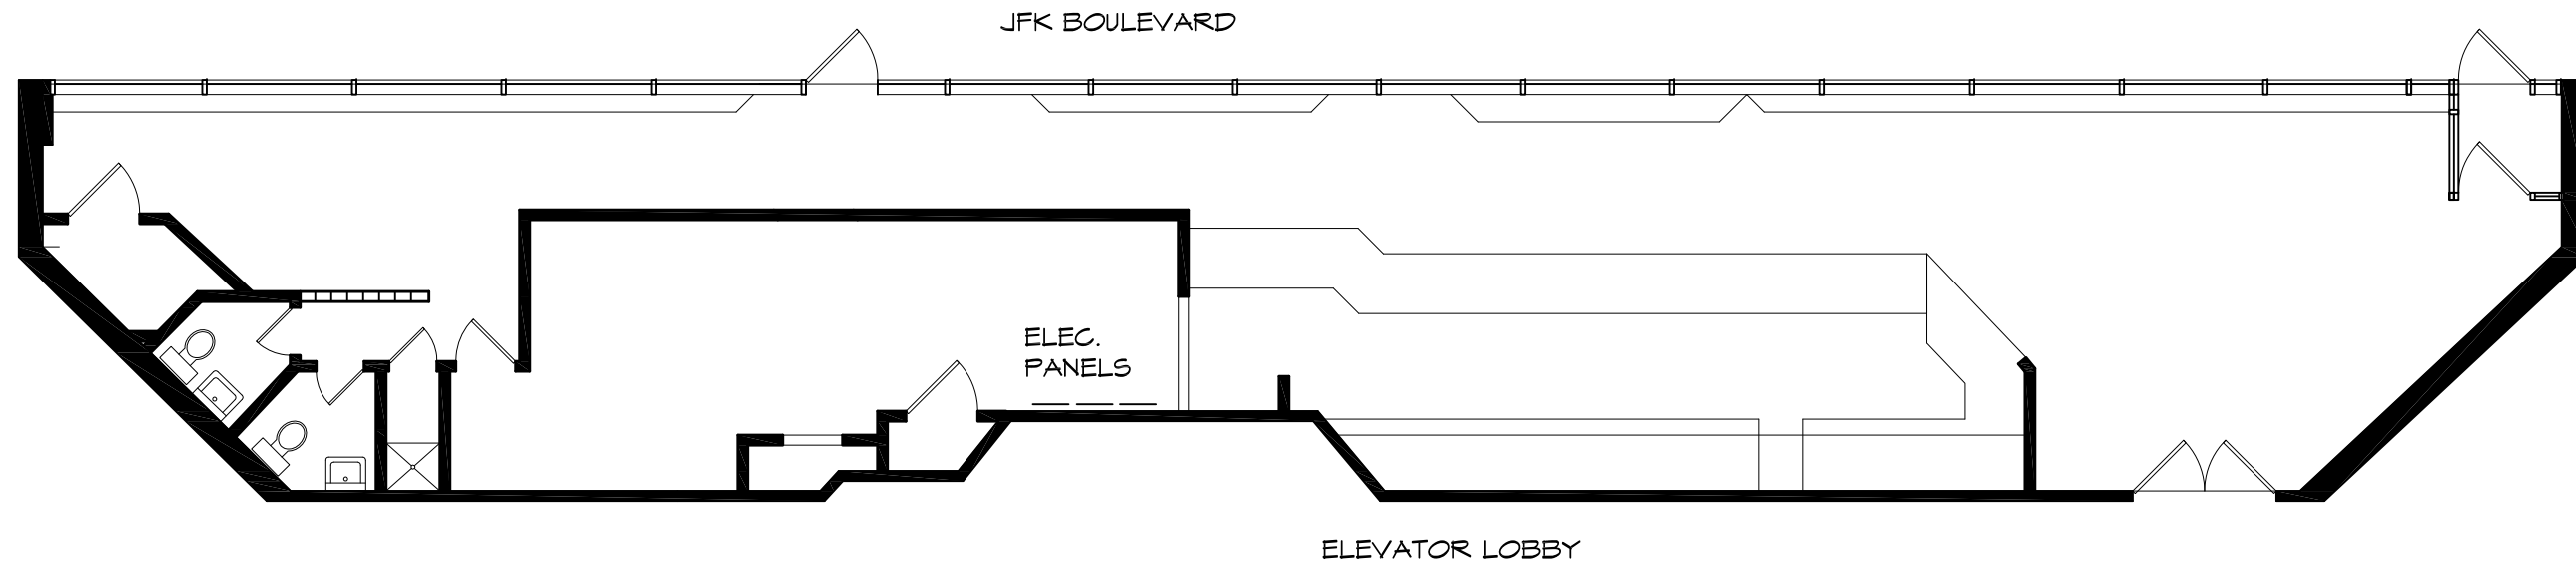

1 RECORD CONDITION PLAN
SCALE: 1/8" = 1'-0"

RECORD CONDITION PLAN		LEGEND
Symbol	Description	
	EXISTING PARTITION - REMOVE EXISTING FINISHES AND PREPARE TO RECEIVE NEW FINISHES IN SMOOTH AND MONOLITHIC APPEARANCE.	
	EXISTING LOW PARTITION @ HEIGHT VARIES	
	EXISTING DOOR	

1ST FLOOR
RETAIL SPACE

1880 JFK
PHILADELPHIA, PA

RECORD CONDITIONS PLAN


PROJECT #:	03 046.01
SCALE:	AS NOTED
DRAWN BY:	AP
CHECKED BY:	
DATE:	12/29/2003

REVISIONS:	
1 2	

RC-1-1880

SHEET 1 OF 1

COPYRIGHT © 2003 PARTRIDGE ARCHITECTS, INC.

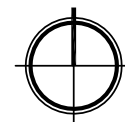

G:\1800-1880 JFK\1800JFK\1800JFK BASE PLANS\RECORD CONDITIONS\01F-BASEPLAN-1880JFK.DWG