


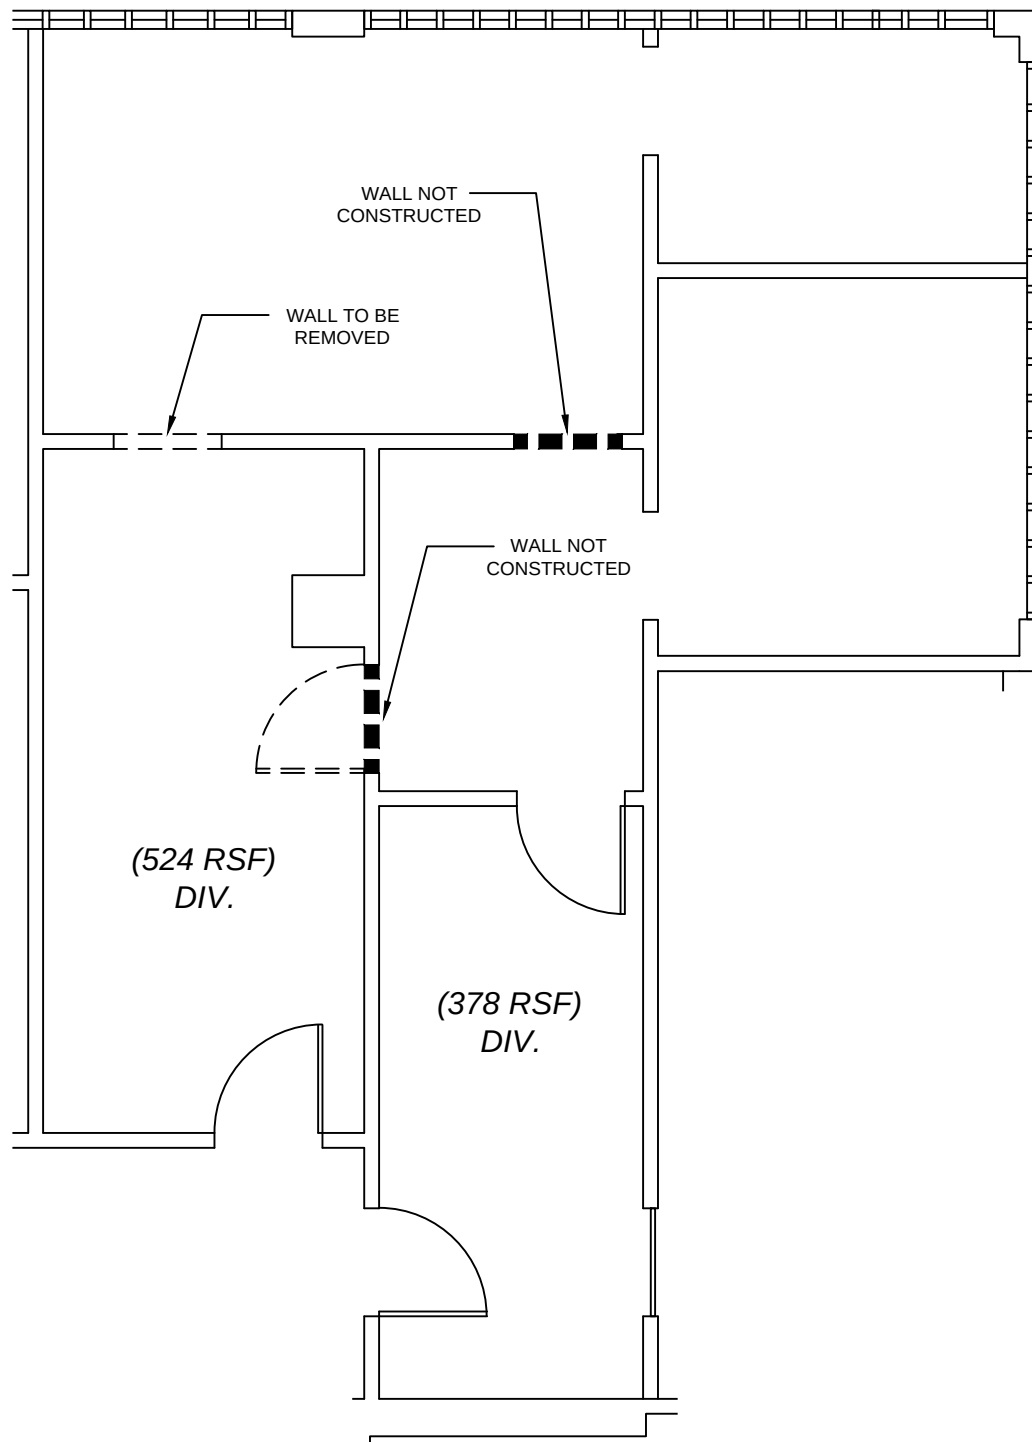

2725

N. THATCHER AVE
RIVER GROVE, IL

SUITE 111

902 RSF
(DIV.)
As Noted

IMPERIAL REALTY COMPANY



4747 W. PETERSON AVENUE
CHICAGO, ILLINOIS 60646
SUITE 200
T 773.736.4100
F 773.736.4541
www.imperialrealtyco.com