


TOTAL SF AVAILABLE -4,057 RSF

OFFICE - 1,451 RSF


WAREHOUSE - 2,607 RSF

* INCLUDES % OF METER ROOM

[Click to access CADD file](#)

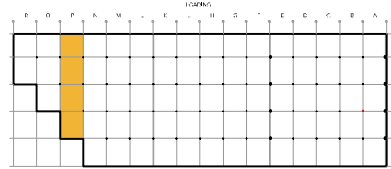

Key Plan

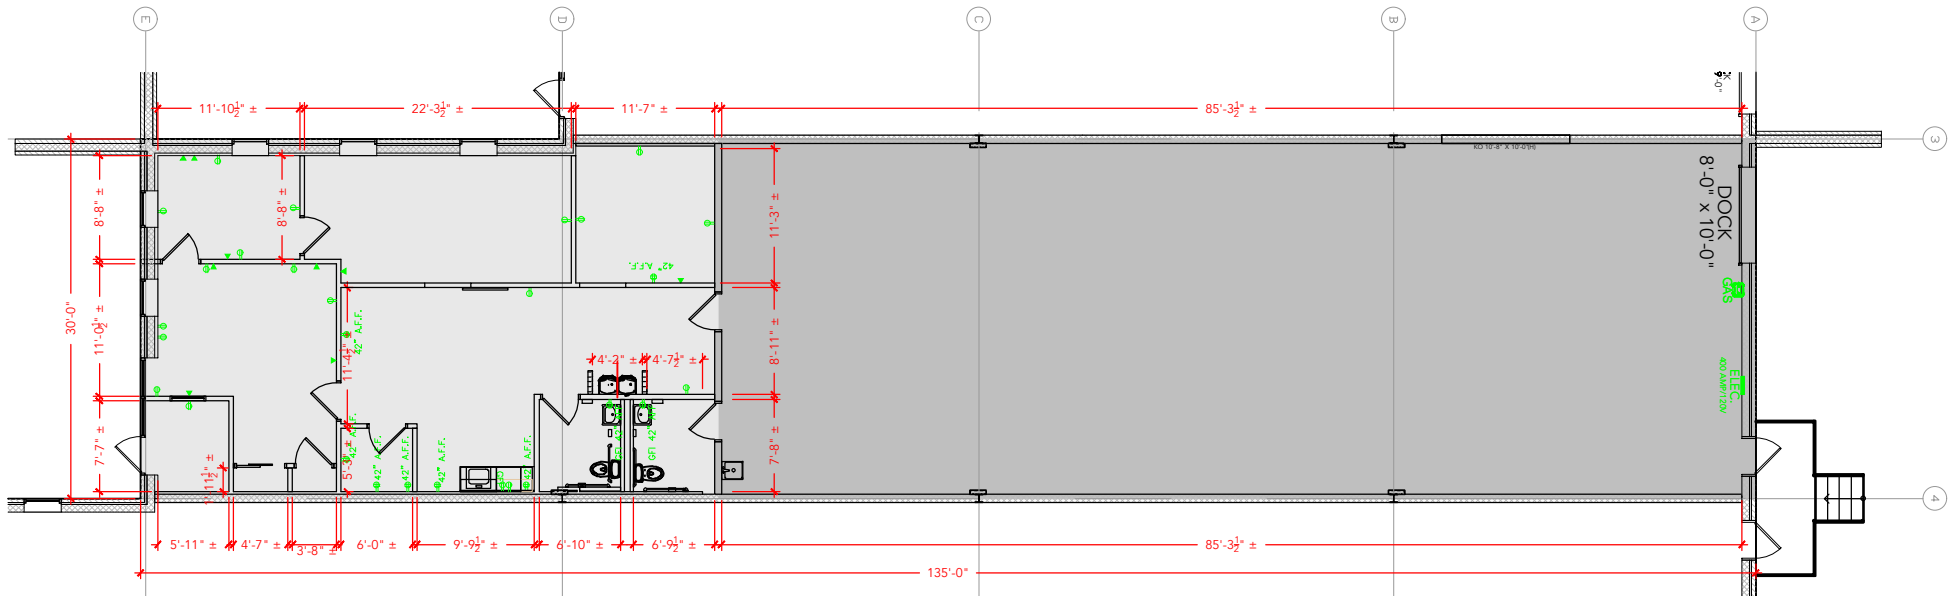

Floor Plan