


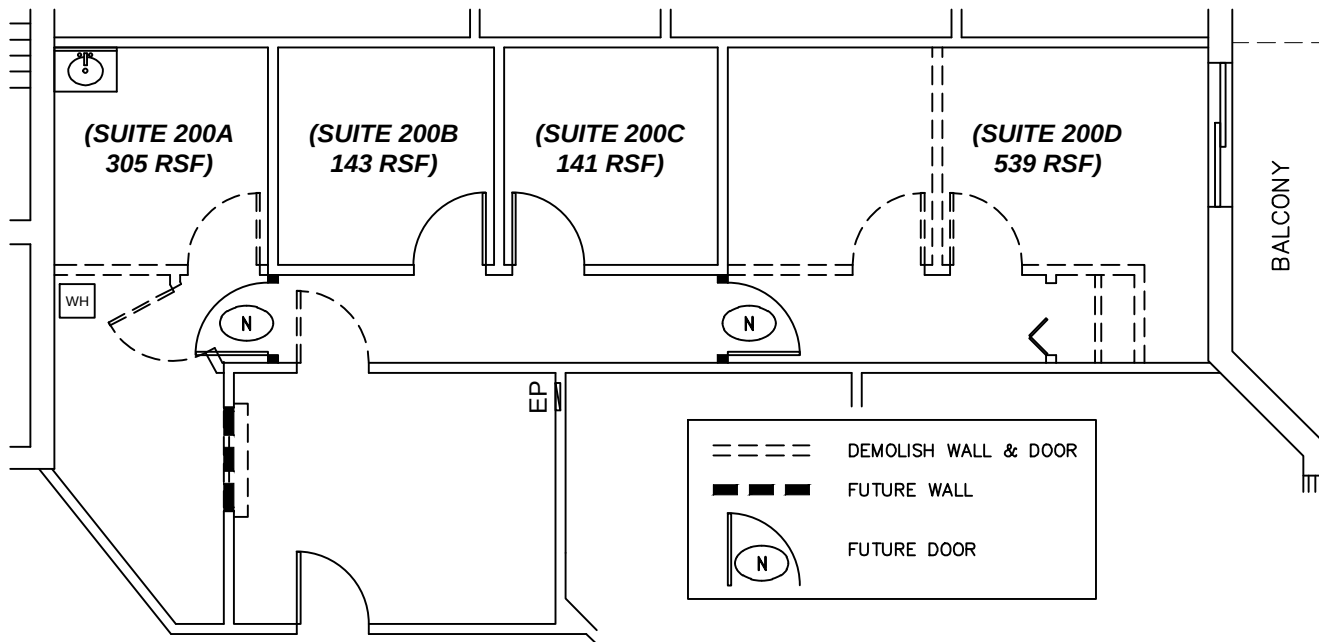

1580

N. NORTHWEST HWY
PARK RIDGE, IL

SUITE 200

1,128 RSF
DIV.
AS NOTED

IMPERIAL REALTY COMPANY



4747 W. PETERSON AVENUE
CHICAGO, ILLINOIS 60646
SUITE 200
T 773.736.4100
F 773.736.4541
www.imperialrealtyco.com