


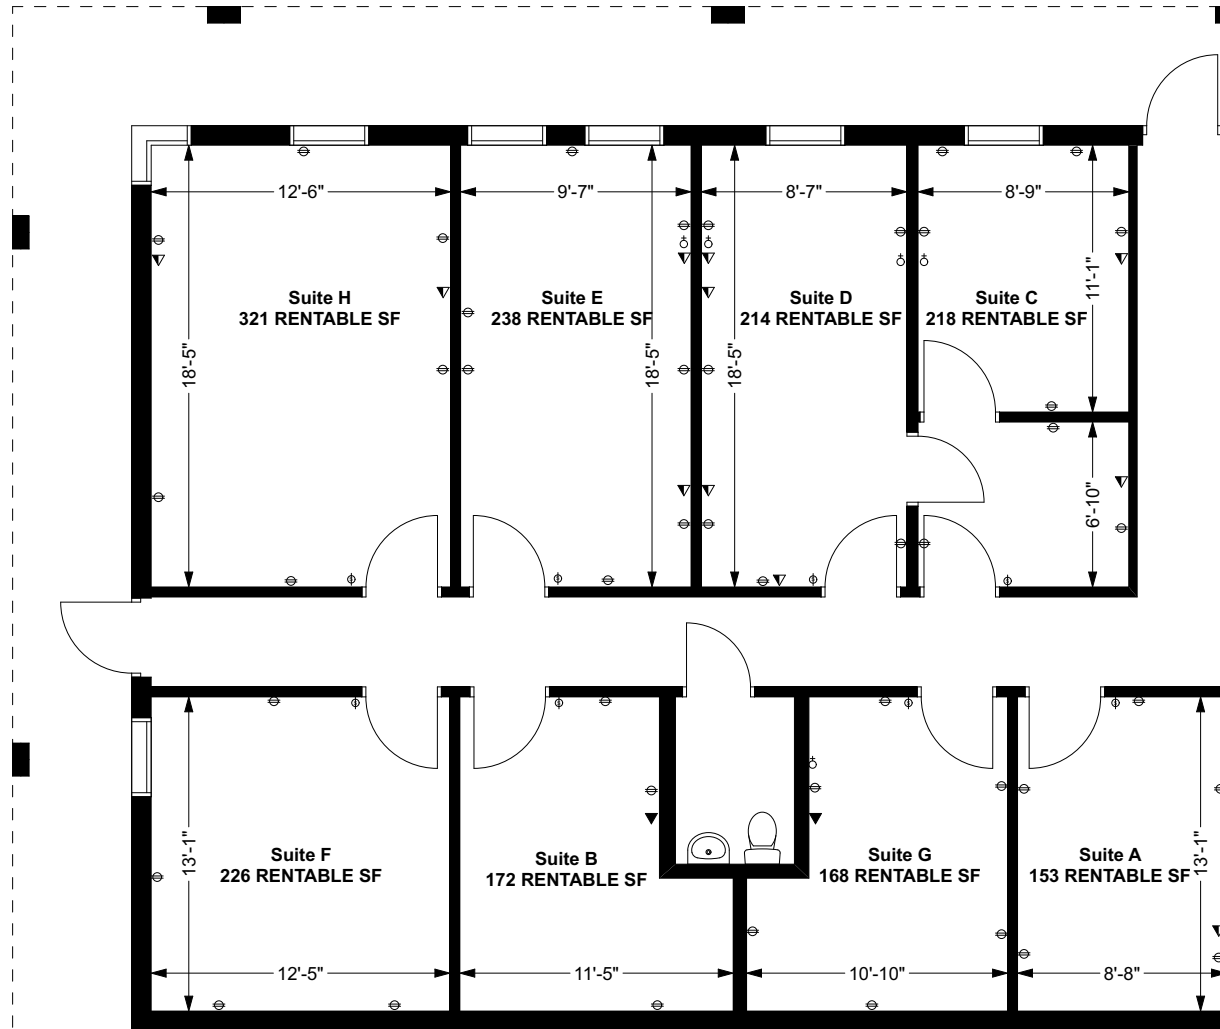

Wall Plan Legend

	THERMOSTAT		CABLE RECEPTACLE
	DOUBLE RECEPTACLE		ELECTRICAL PANEL
	QUAD RECEPTACLE		VOICE RECEPTACLE
	SINGLE SWITCH		DATA RECEPTACLE
	DOUBLE SWITCH		VOICE & DATA RECEPTACLE



95 Office Park
2750 N 29th Avenue
Hollywood, FL 33020

Suite 114
1,710 RENTABLE SF

Measured: 03/18/21
 Prepared: 05/08/21

Plan Version: V1

Leasing & Management:

FIRM Realty
 1930 Harrison Street
 Suite 503
 Hollywood, FL 33020
 (954) 926-2510



phone: (305) 702-0590
www.floridameasures.com
mail@floridameasures.com
[@floridameasures](https://www.instagram.com/floridameasures)



This work product has been prepared by Florida Measures, LLC pursuant to a contract with the Client for the sole benefit of and use by the Client. No third party may rely on this work product without the receipt of a reliance letter from Florida Measures, LLC.