

FOR SALE OR LEASE



24,778 SF Office/Flex Building

24710 W 11 Mile Road • Southfield, MI



Kurt Weber
248 226 1870
Kurt.weber@colliers.com



John Fricke
248 872 7820
John.fricke@colliers.com



Colliers Detroit
400 W 4th Street, Suite 350
Royal Oak, MI 48067
colliers.com/detroit






PROPERTY HIGHLIGHTS

- 24,778 SF
- 2-Story Office Building
- High-end Finishes
- Flex Potential
- Partially Furnished
- Freeway Exposure
- \$1,600,000 Purchase Price
- \$16.00 Gross Plus Utilities

SET AMONG 3 MAJOR THOROUGHFARES

24,778 SF Office/Flex Building



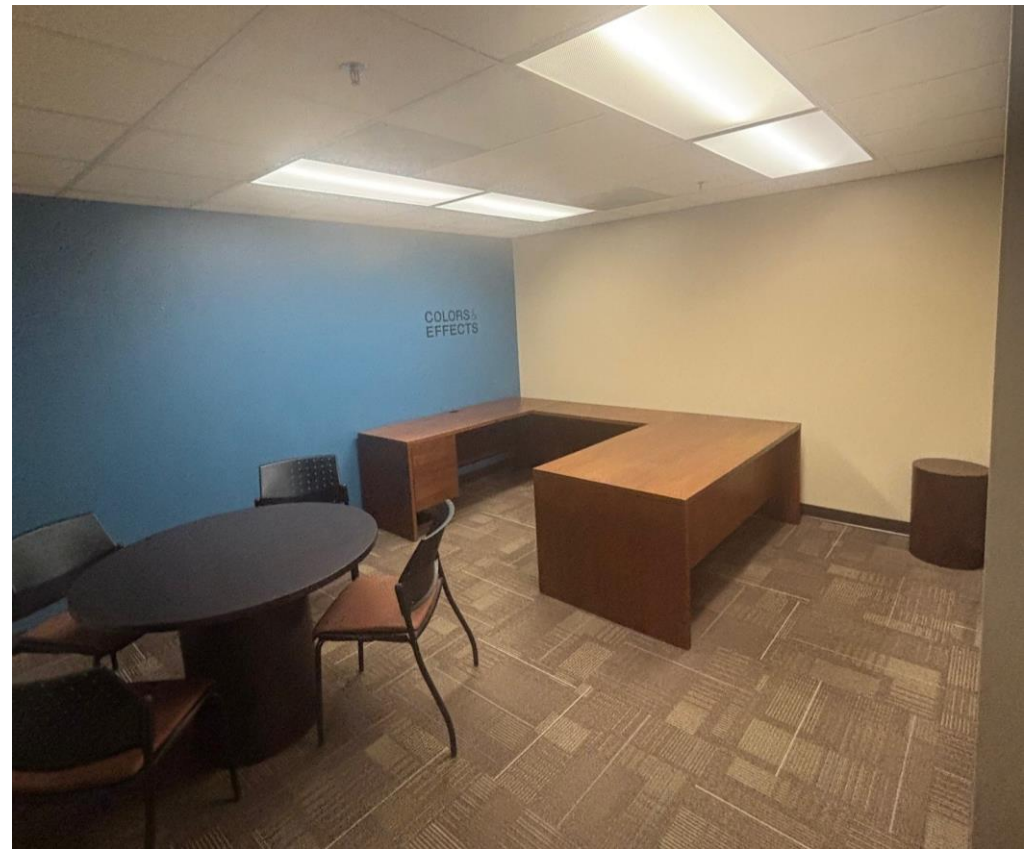

INTERIOR PHOTOS

24,778 SF Office/Flex Building






FREEWAY SIGNAGE POTENTIAL


24,778 SF Office/Flex Building



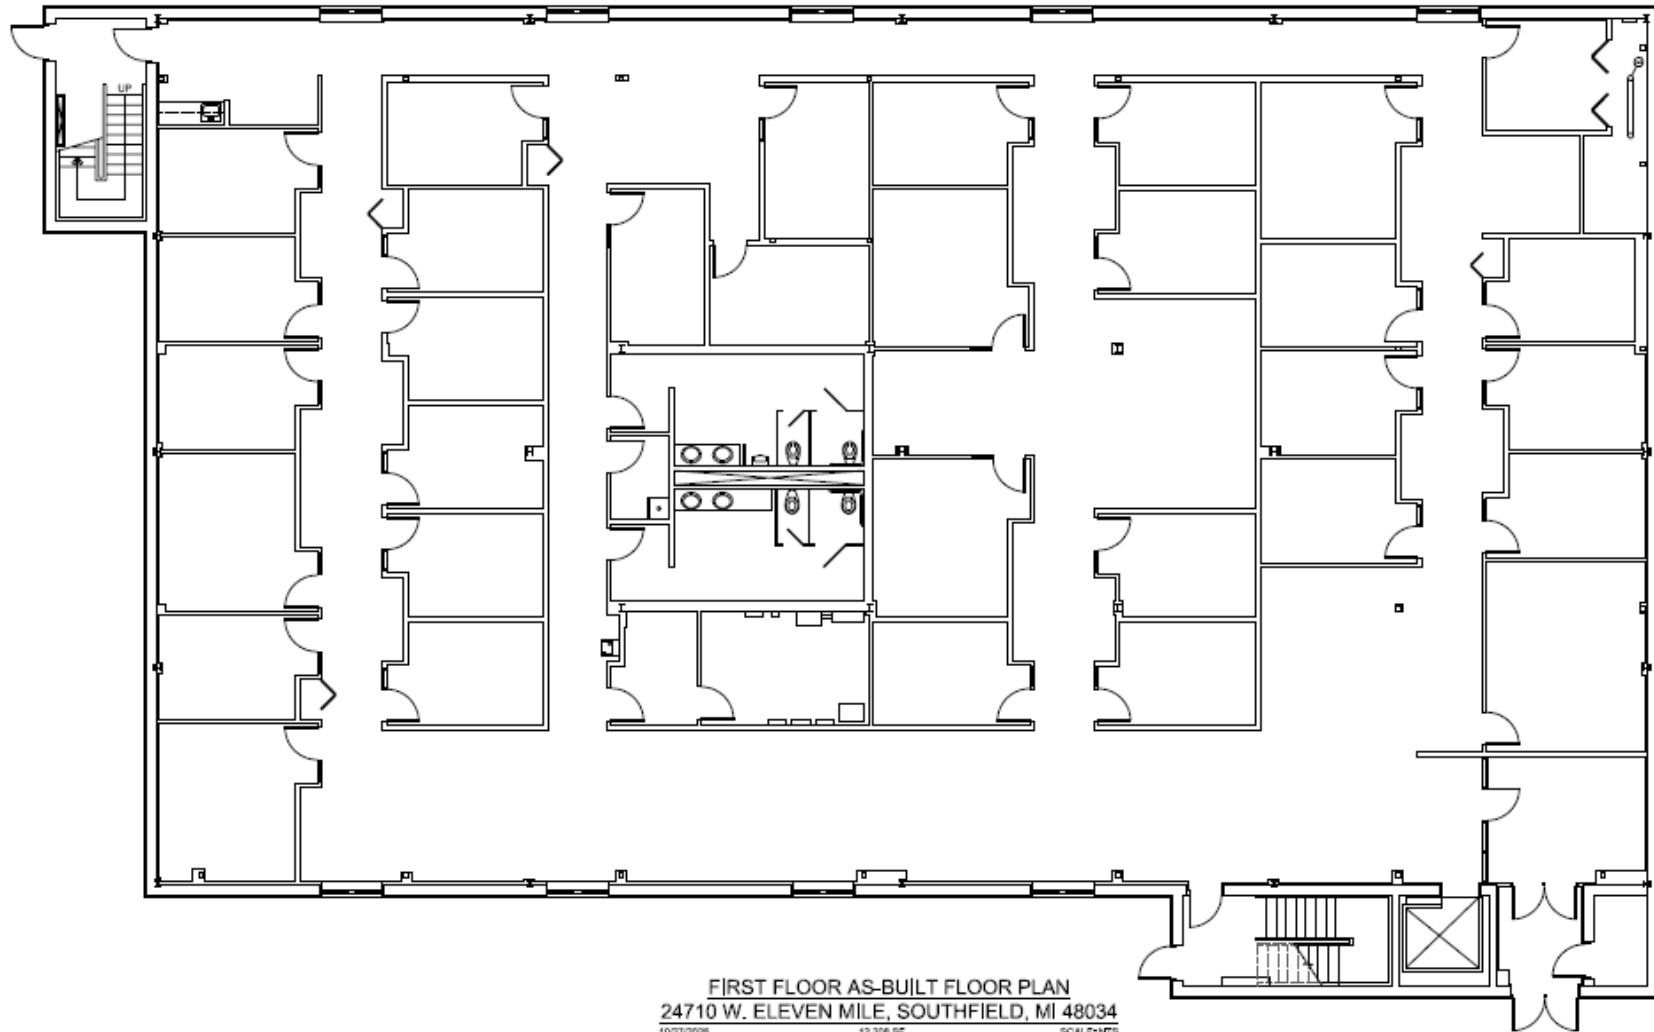


FLOOR PLAN

24,778 SF Office/Flex Building

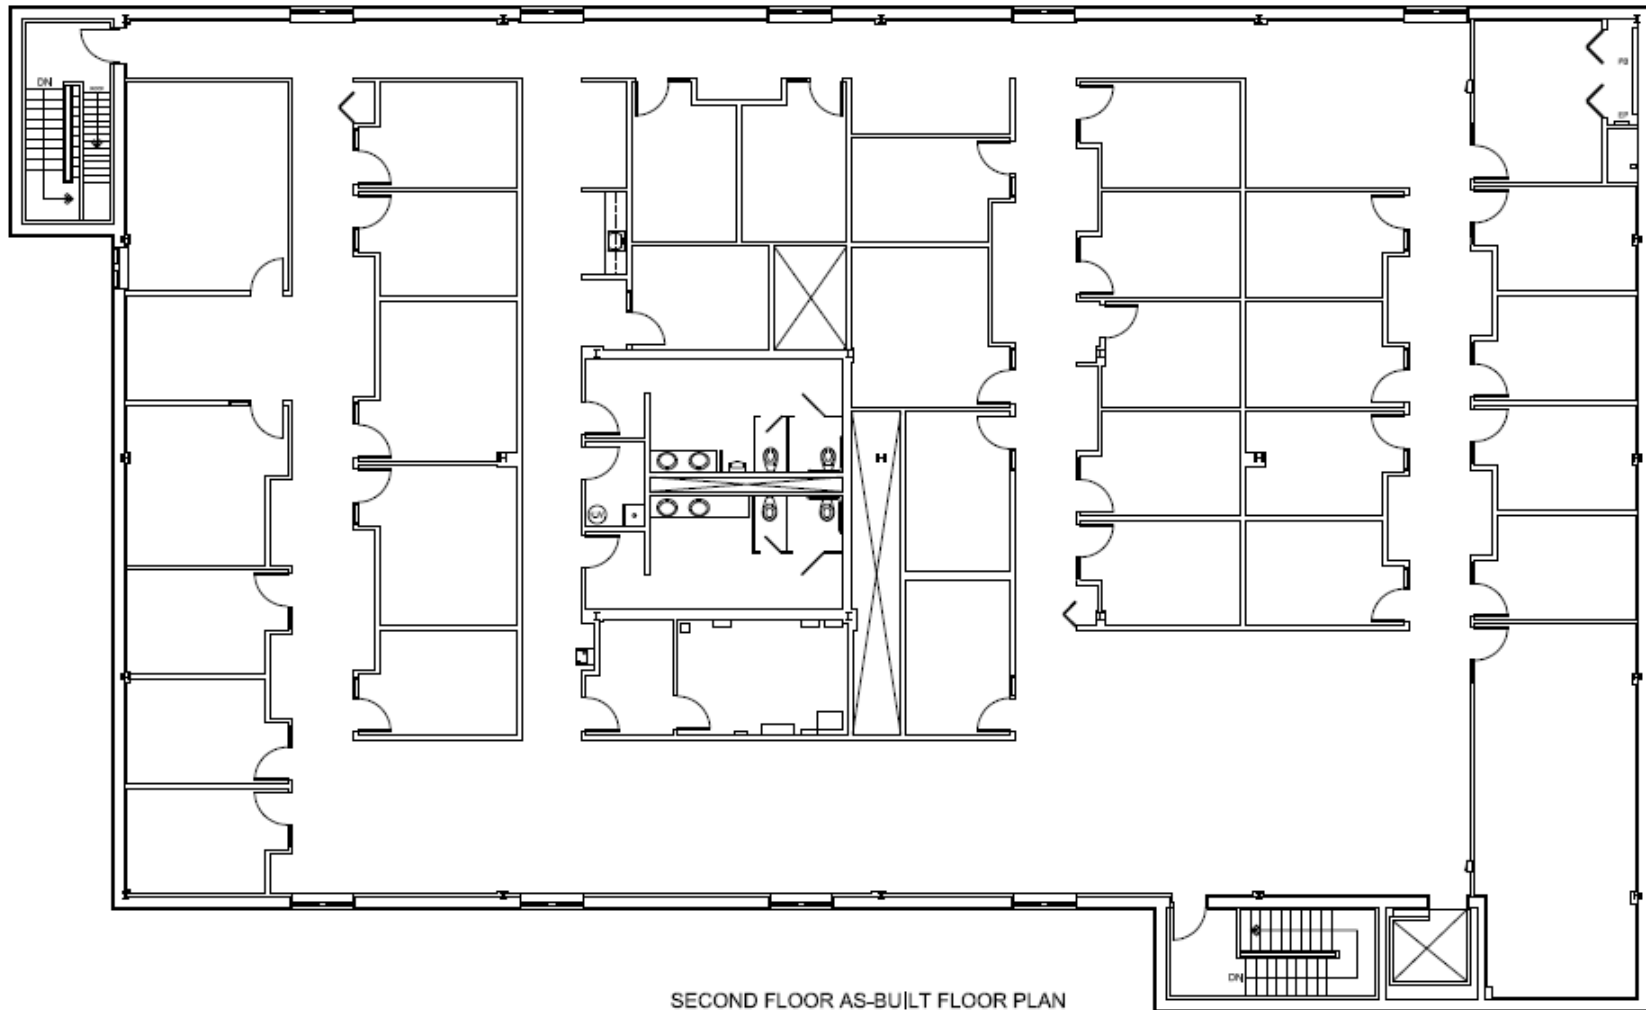

FLOOR PLAN

24,778 SF Office/Flex Building

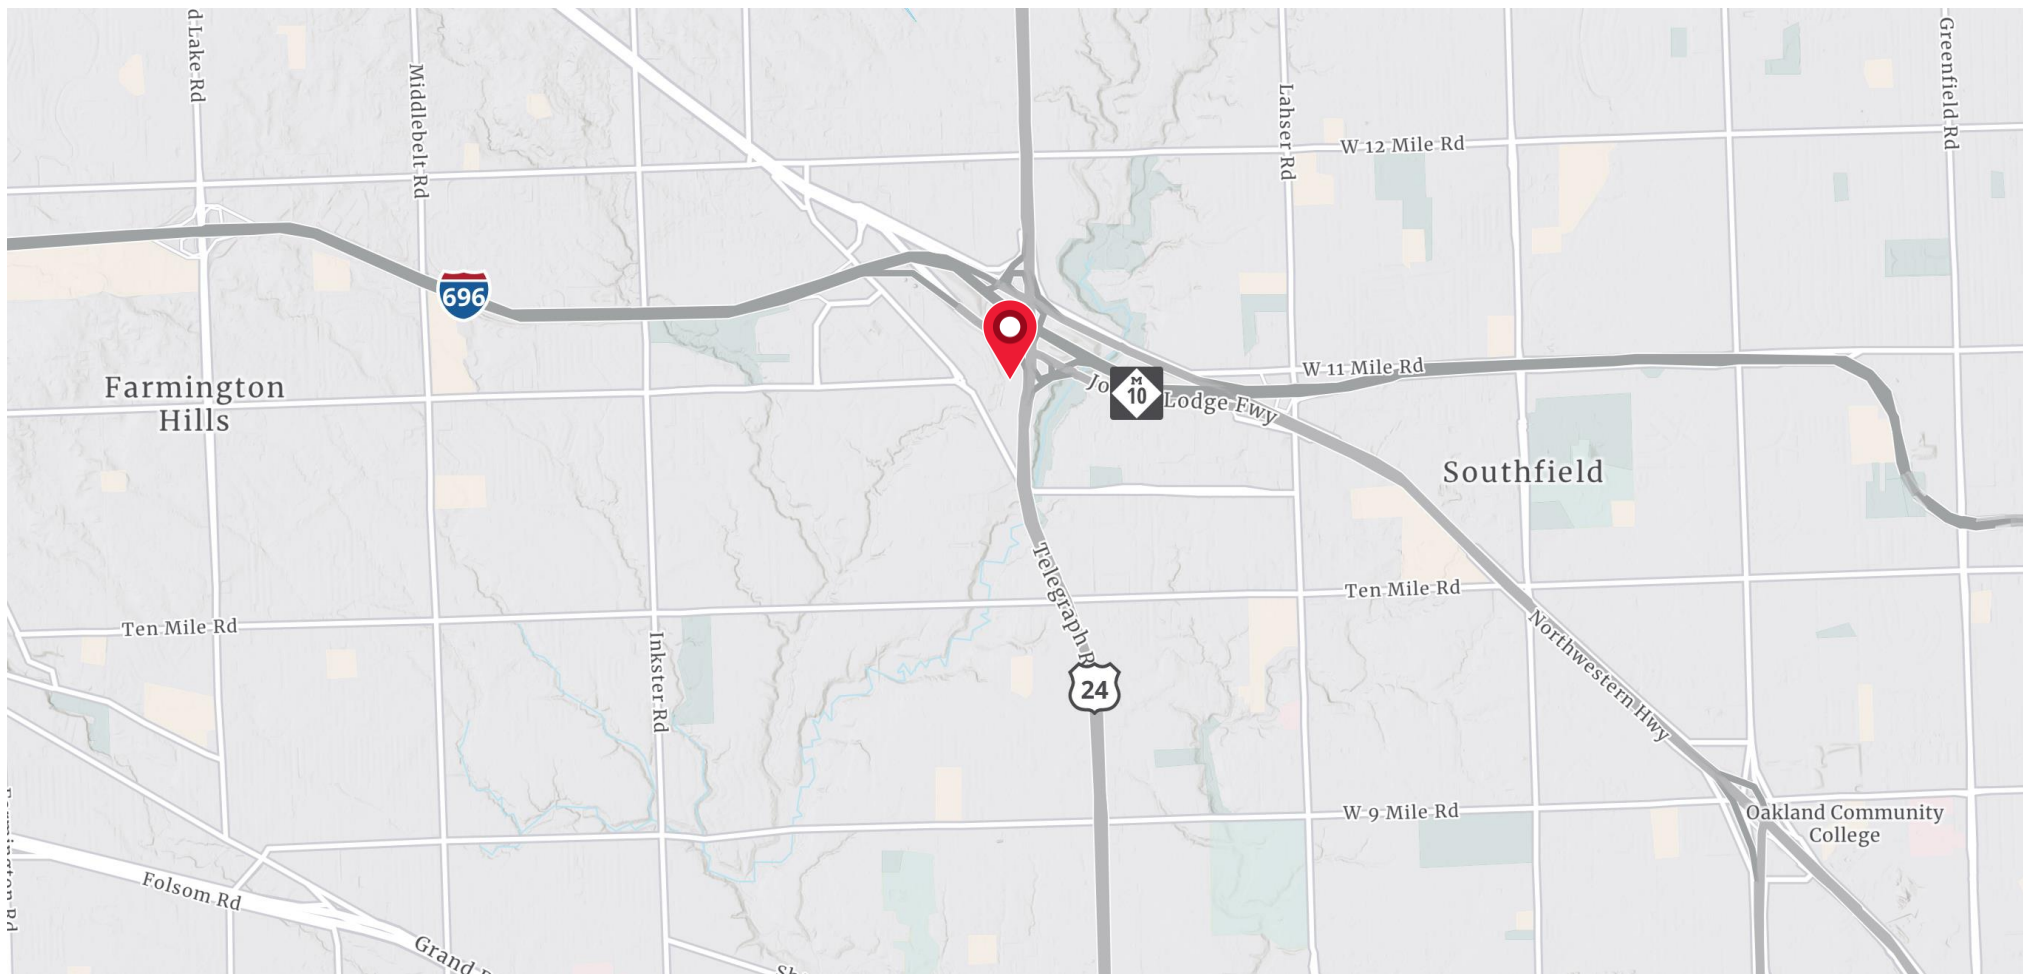

LOCATION MAP

24,778 SF Office/Flex Building

We have no reason to doubt the accuracy of information contained herein, but we cannot guarantee it.
All information should be verified prior to purchase and/or lease.

Kurt Weber

248 226 1870

Kurt.weber@colliers.com



John Fricke

248 872 7820

John.fricke@colliers.com



Colliers Detroit

400 W 4th Street, Suite 350
Royal Oak, MI 48067
colliers.com/detroit

