

Certificate Of Survey

Located in NW 1/4 NW 1/4 Section 15, T.21 N., R.29 W. &
SW 1/4 SW 1/4, Section 10, T.21 N., R.29 W., P.M.M.

Purpose Of Survey

Retracement, Parcel One, WD 11824


Legal Description

Line Table

	Brg	HDist
L1	N59°01'56"W	192.92
L2	N59°01'56"W	132.24
L3	S0°30'54"E	7.89 (S0°E 4.5)

Legal Description Parcel 1

The True Point of Beginning being The Northwest Corner Section 15; thence along the West Line of said Section 15 S0°30'54"E for 7.89 Feet to the northeastern edge of Montana 200; thence along said edge, S59°00'00"E 498.00 Feet; thence along the Northwestern edge, of a parcel recorded in Deed 13881 N31°30'24"E for 246.64 Feet to the southwestern edge of Montana Rail Link; thence along said edge, N62°50'35"W for 627.04 Feet to the West Line of Section 10; thence along said line, S0°30'54"E for 232.11 Feet to a NW Corner Section 15, the True Point of Beginning, the Area being 2.94 ACRES.

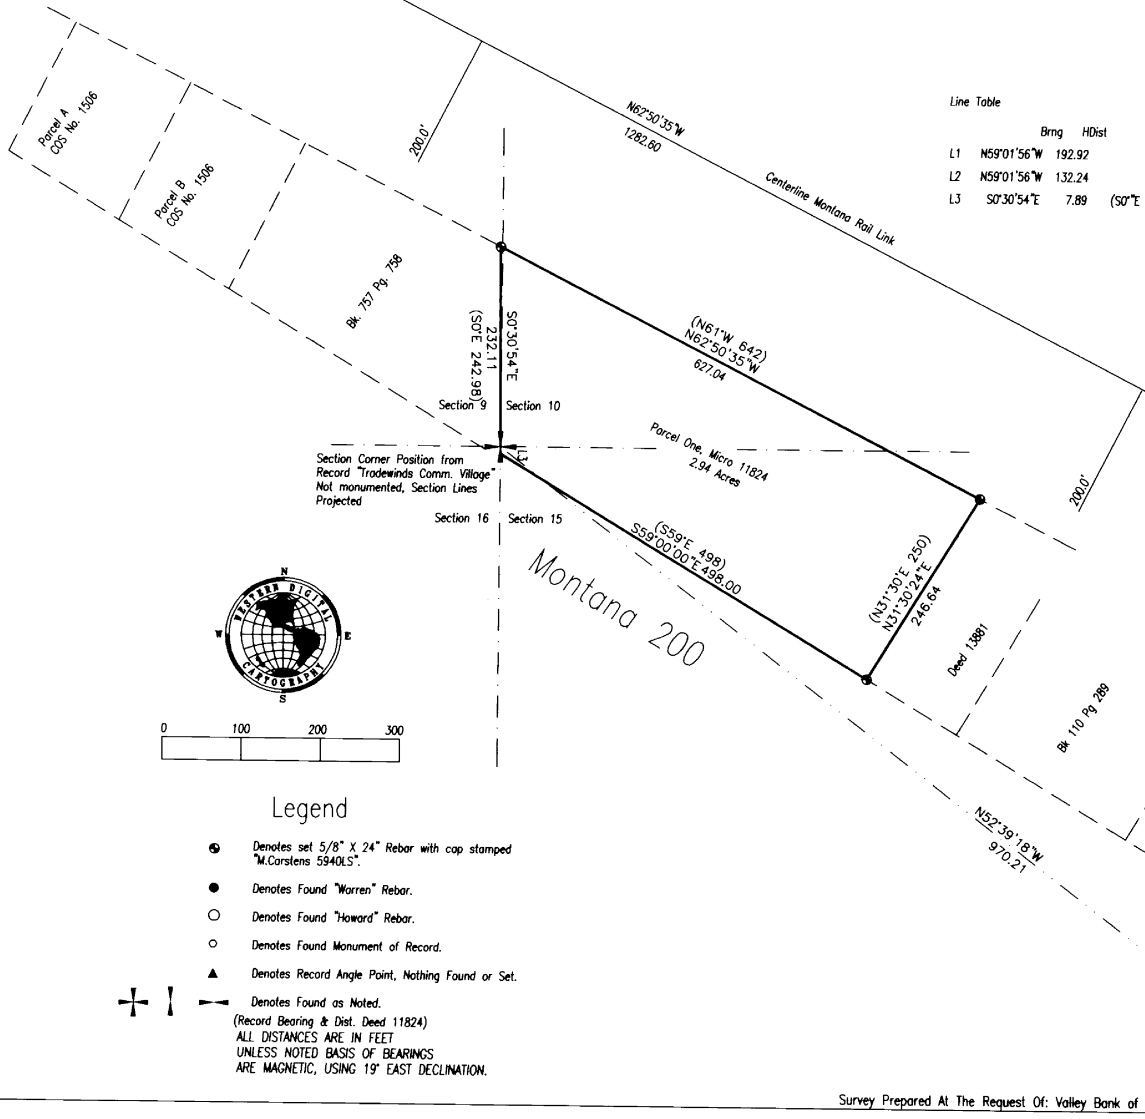

Certificate of Surveyor

Marc J. Carstens 5940 RLS
Thompson Falls, MT.

Approved This 15th Day Of June 1998

James R. Edwards No Deed required
Sanders County Environmental Health

Spencer Burns Planning Asst.
Sanders County Planning Department

Filed For Record This 15th Day Of June, 1998

At 2:00 o'clock P.M.
Clerk And Recorder

By Patricia M. Magrath
Deputy

Certificate Of Survey No. 1883

Survey Prepared At The Request Of: Valley Bank of Ronan

Jun 1998