


16'-2"

11'-0"

10'-0"

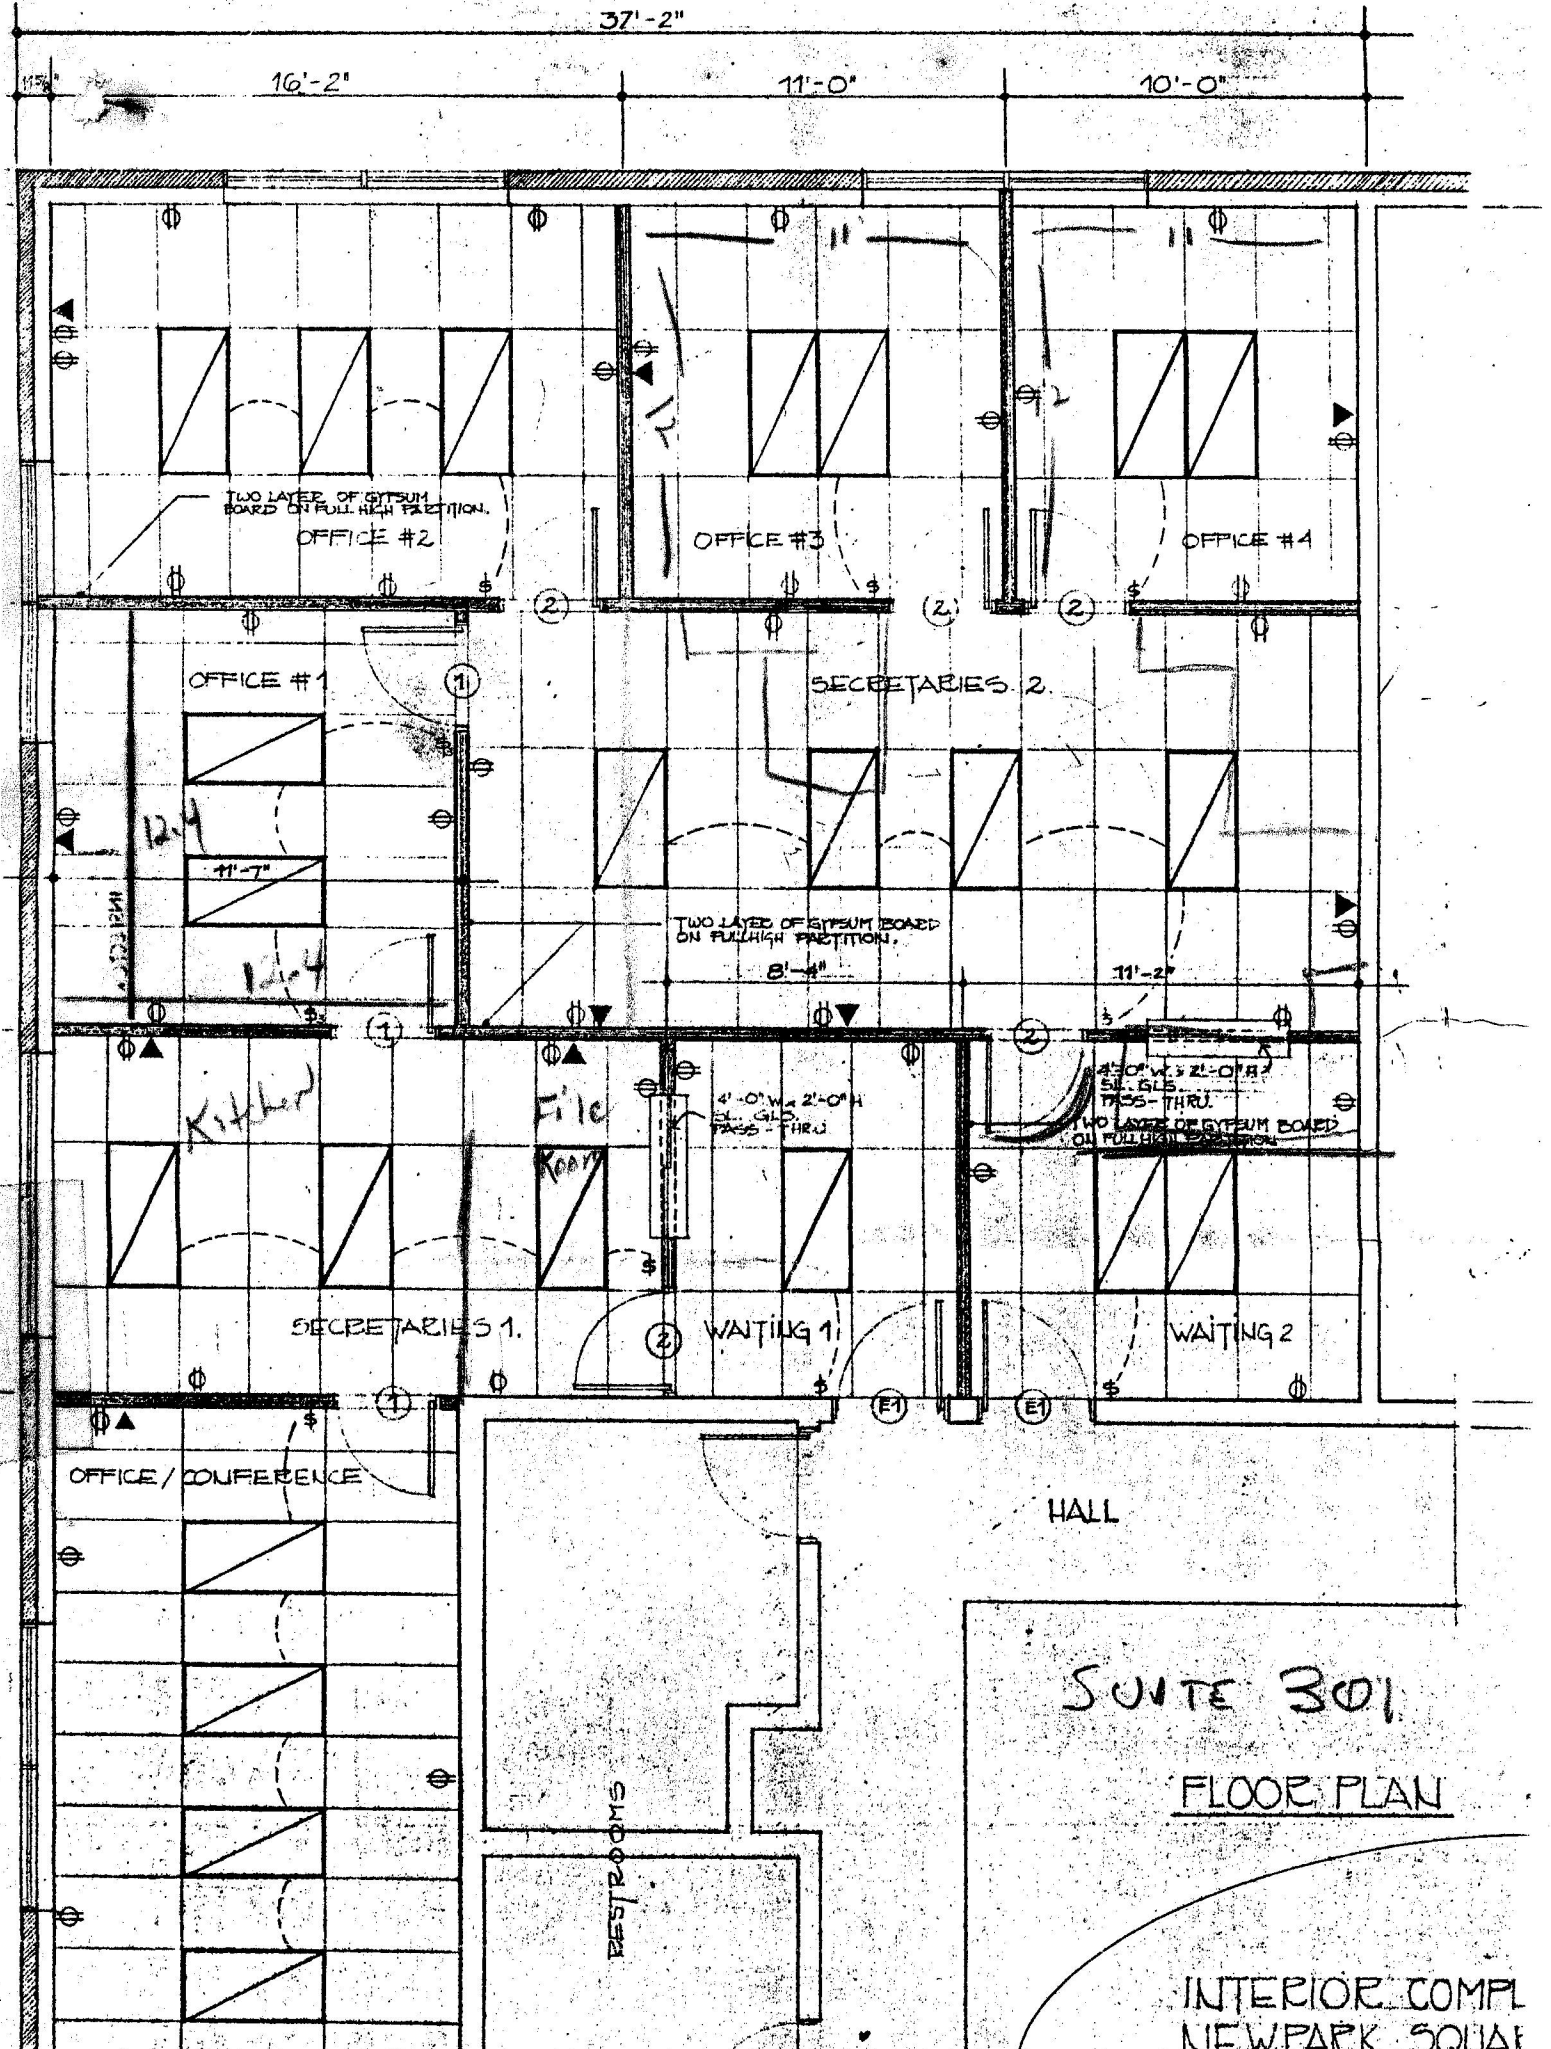

SUITE 301
FLOOR PLAN

INTERIOR COMPL
NEW PARK SQUARE