


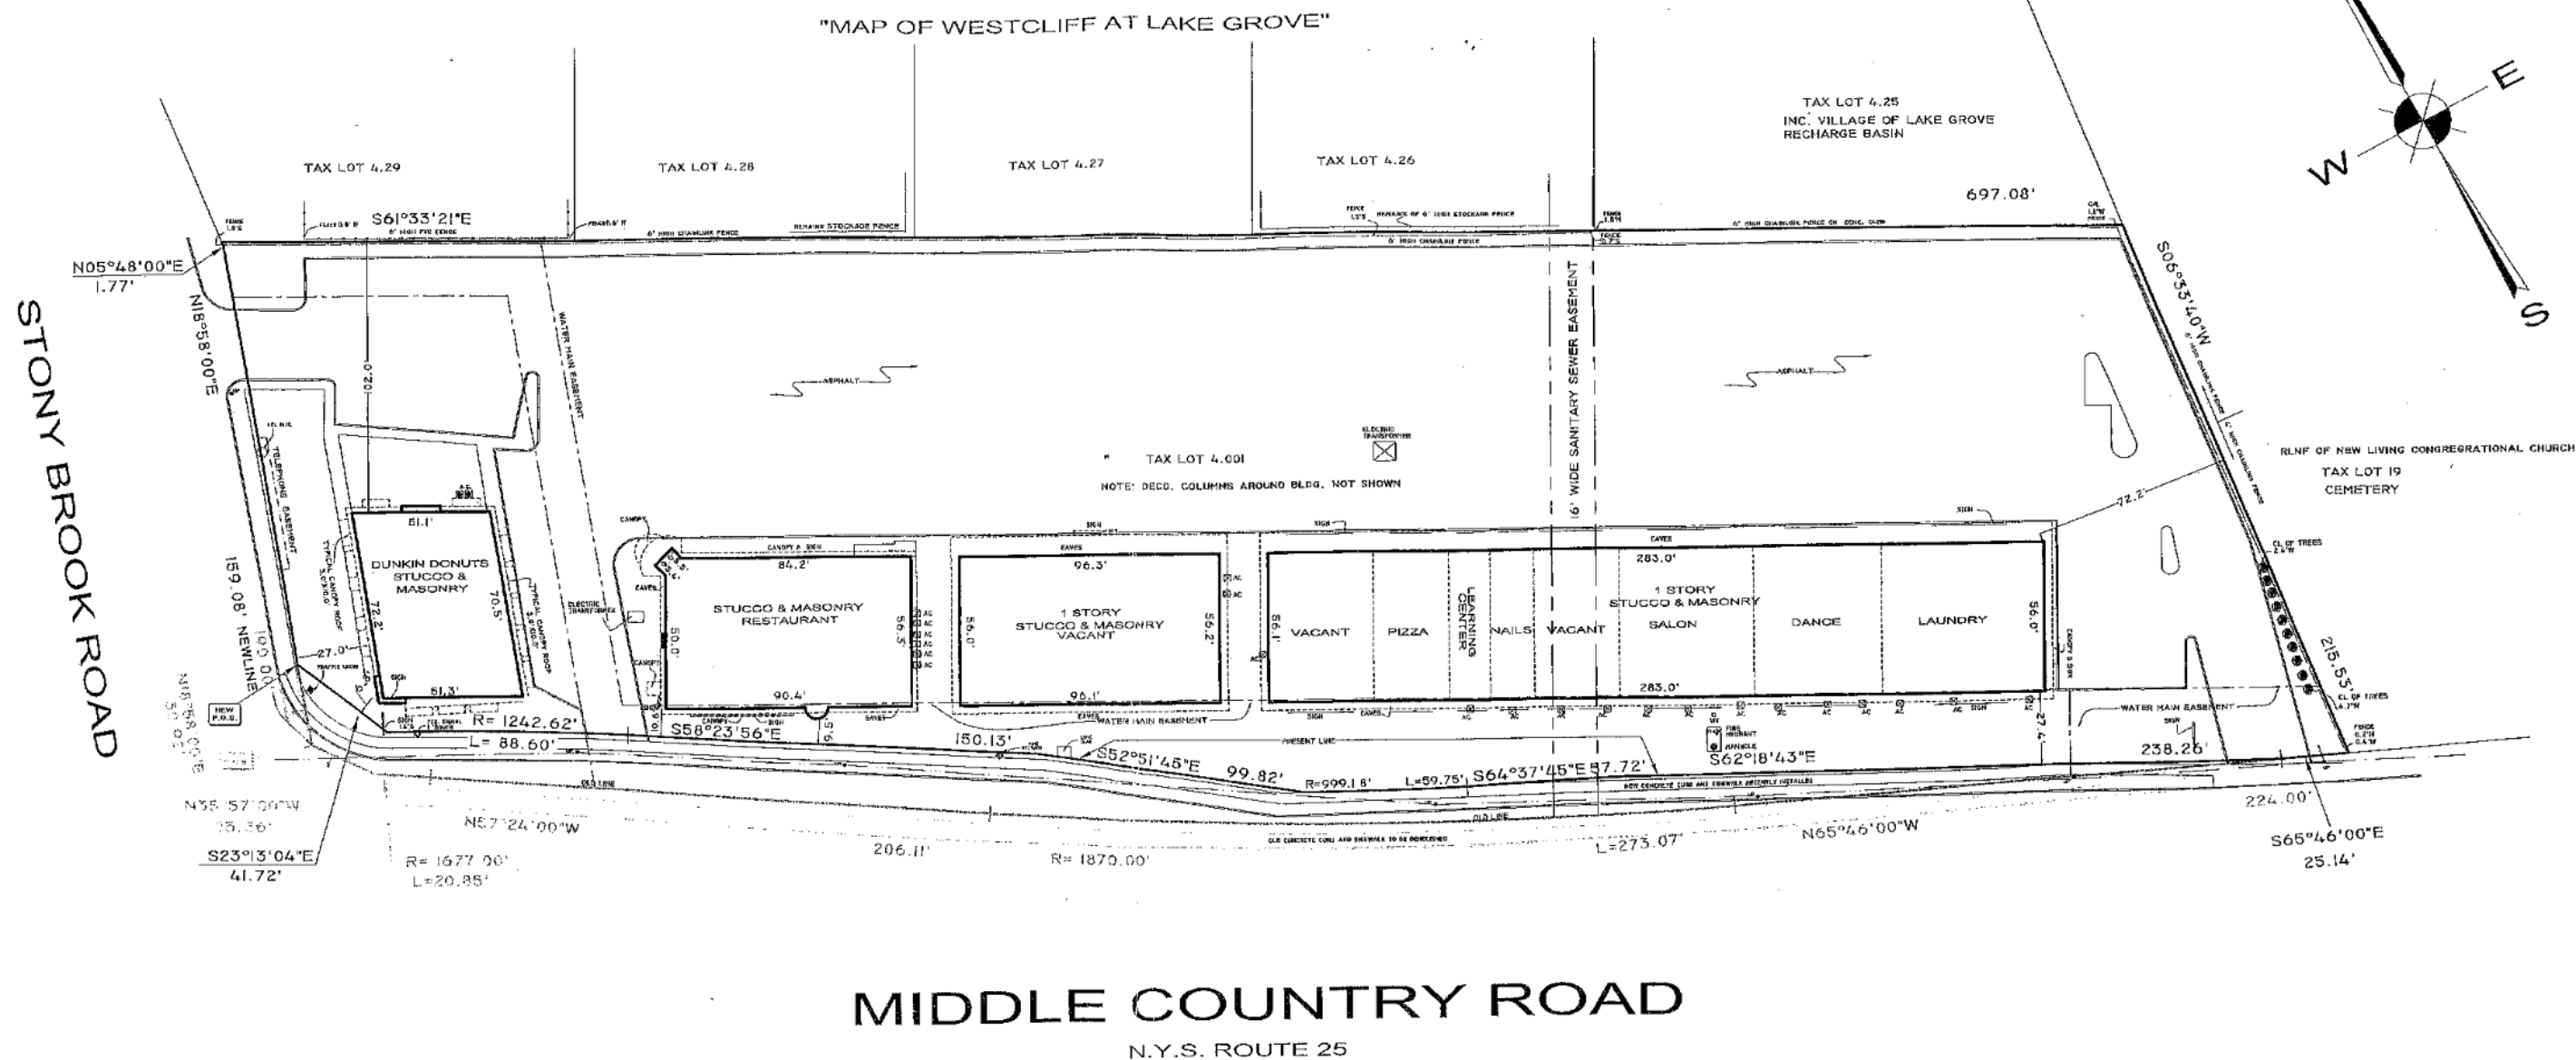

TITLE No.:
 CERTIFIED ONLY TO: ALDRICH MANAGEMENT CO., LLC
 PEOPLE'S UNITED BANK
 ISLAND ABSTRACT, INC.
 FIDELITY NATIONAL TITLE INSURANCE CO.

SURVEY TO BE USED SOLELY FOR THE
 PURPOSE OF THE CONVEYANCE OF TITLE
 OR MORTGAGE. OFFSETS SHOWN NOT
 TO BE USED FOR THE REMOVAL OR
 LAYOUT OF FENCES, HEDGES, CURBS,

CERTIFICATIONS INDICATED HEREON SHALL RUN
 ONLY TO THE PERSON FOR WHOM THE SURVEY
 IS PREPARED, AND ON HIS BEHALF TO THE
 TITLE COMPANY GOVERNMENTAL AGENCY AND
 LENDING INSTITUTION LISTED HEREON, AND
 TO THE ASSIGNEES OF THE LENDING INSTITUTION.
 CERTIFICATIONS ARE NOT TRANSFERABLE
 TO ADDITIONAL INSTITUTIONS OR SUBSEQUENT OWNERS

LEGEND:

W/S - WEST SIDE
 MH - MAN HOLE
 CB - CATCH BASIN
 DI - DROP INLET
 GAR - GARAGE
 UP - UTILITY POLE
 CONC. - CONCRETE
 PE - FENCE
 P.O.B. - POINT OF BEGINNING
 ENCH. - ENCROACHING
 LT - TYPICAL LIGHT
 DN - DOWN



No.	REVISION DESCRIPTION	DATE	BY
1			
2			
3			
4			
5			

SITE DATA:

NEW AREA OF PLOT = 142,363.8 SQ. FT.

MAP OF PROPERTY

LOCATED AT
 INC. VILLAGE OF LAKE GROVE, TOWN OF BROOKHAVEN, SUFFOLK COUNTY, NEW YORK
 DISTRICT: 0208, SECTION: 014.00, BLOCK: 03.00, LOT: 004.001
 SCALE: 1"=50' DATE: 06-26-2010

PREPARED BY

JOHN P. FERRANTELO P.C.
 LICENSED LAND SURVEYOR
 SITE PLANNING CONSULTANTS



LAND SURVEYING
 PHONE
 516-294-8570

LAND PLANNING
 FAX
 516-294-8570

