ROUTE SEVEN

9331 PHILADELPHIA ROAD,BALTIMORE, MD 21237


SUITE E(FRONT)-H

TOTAL SF AVAILABLE -13,650 SF


OFFICE - 3,126 SF

WAREHOUSE - 10,524 SF

Click to access **CADD file**

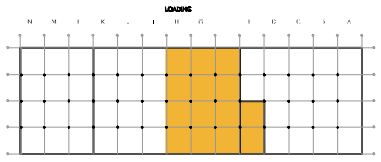

Key Plan

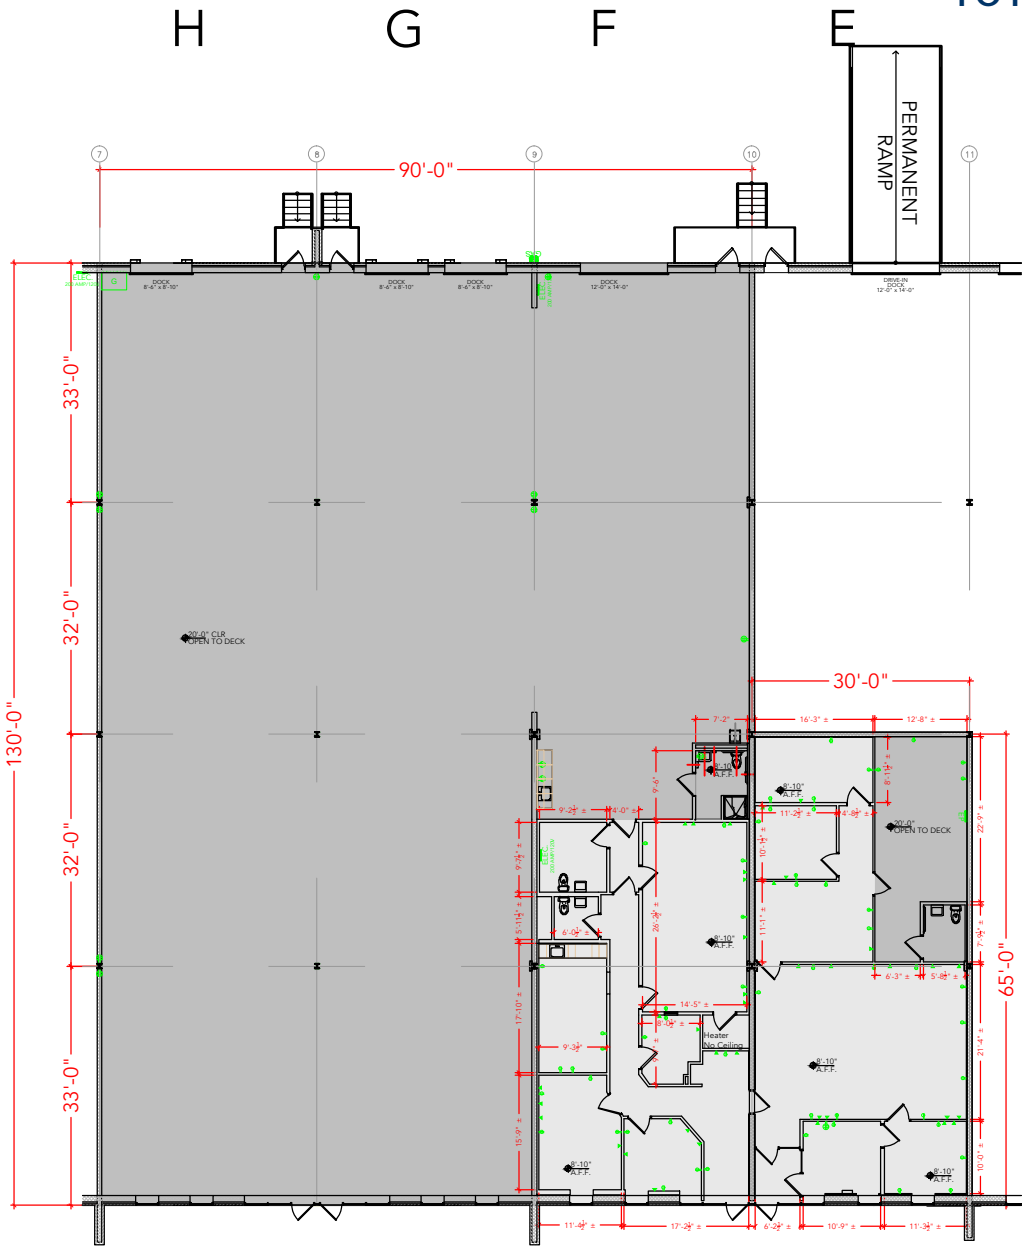

Floor Plan

PLAN NOT TO SCALE - THIS IS NOT A CONSTRUCTION DOCUMENT

DRAWING #: HI1-9331-E (F)-H ASBUILT DATE 01.27.2023