


Suite 1025

4,225 sf


Available: Immediately
Condition: Future show suite

Available Space

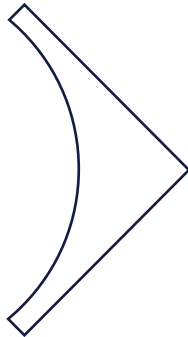

Upgraded kitchen and new
boardroom coming Q2, 2025

Show Suite Layout

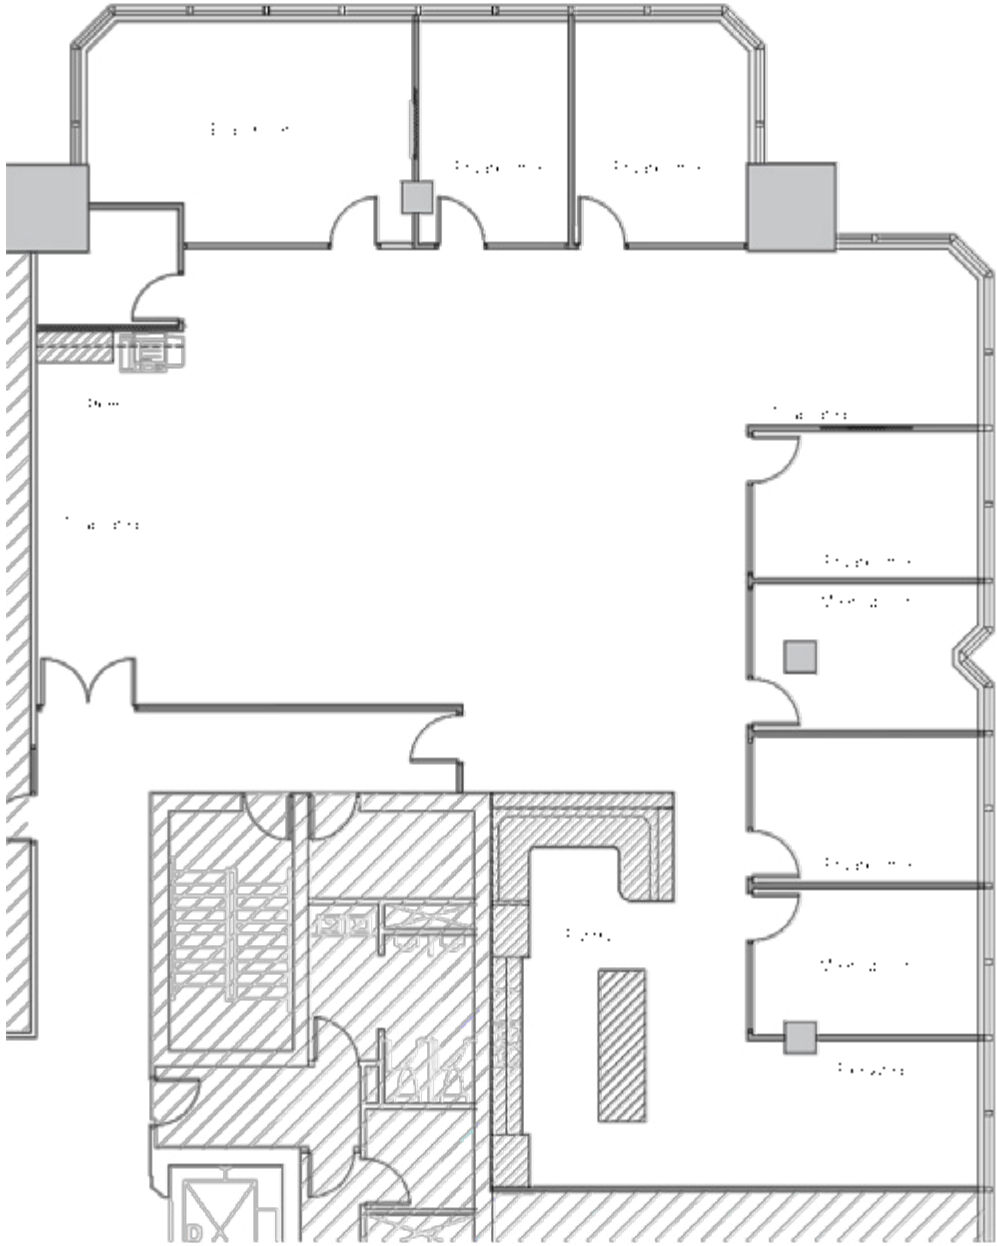

Max Occupancy: 34 Pax (124 PSF)
Proposed Occupancy: 20 Pax (211 PSF)


- | | | | |
|-------------------|---------------|--------------------|-------------------|
| Collab - 2 | Pantry - 1 | Private Office - 4 | Print Station - 1 |
| Workstations - 16 | Flex Area - 1 | Boardroom - 1 | Phone Booth - 2 |
| | | Meeting Rooms - 2 | IT Room - 1 |

Suite 1025

4,225 sf



Show Suite Furniture Plan

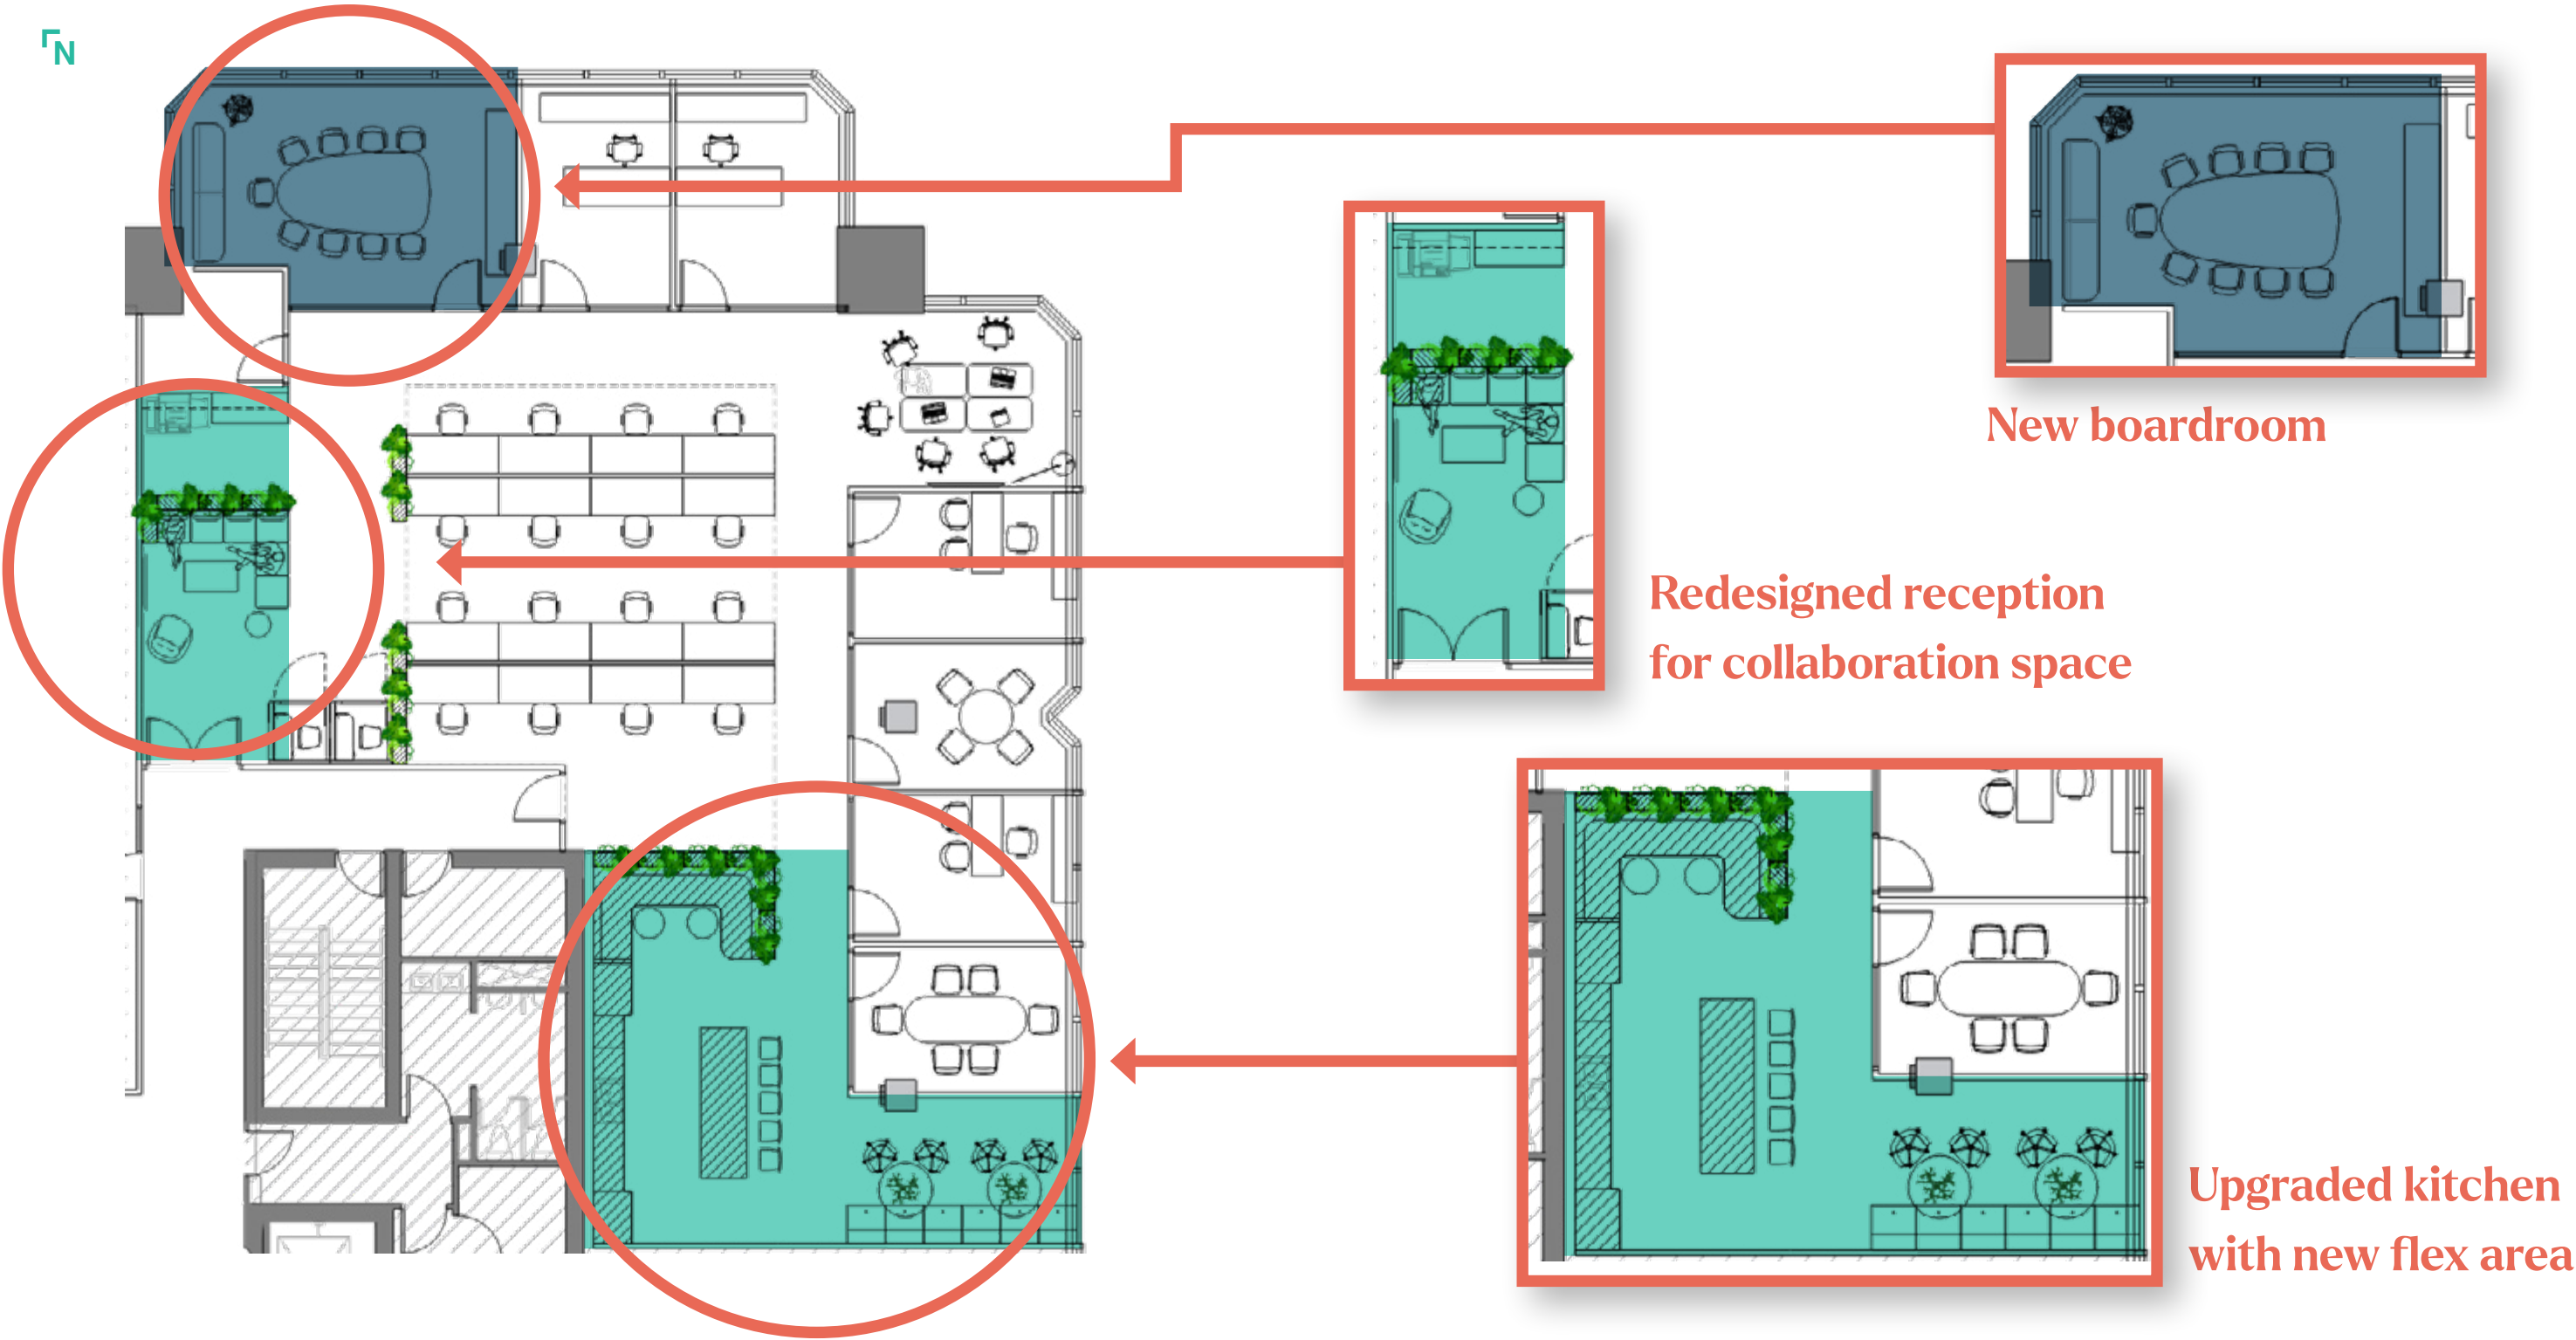

Concept Renderings

10th Floor - Show Suite

